


15-109-20224-00-00

STATE OF KANSAS
STATE CORPORATION COMMISSION

Form CP-4

Give All Information Completely
Make Required Affidavit
Mail or Deliver Report to:
Conservation Division
State Corporation Commission
P. O. Box 17027
Wichita, Kansas 67217
NORTH

WELL PLUGGING RECORD

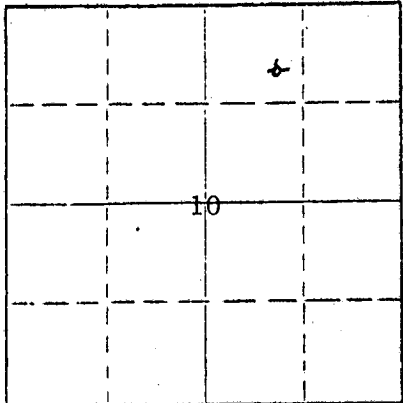

Locate well correctly on above
Section Plat

Logan County, Sec. 10 Twp 14S Rge. (E) 33W (W)
Location as "NE/CNWxSWx" or footage from lines 200' NW of SE NW NE
Lease Owner DONALD C. SLAWSON
Lease Name Smoky Valley 'NN' Well No. 1
Office Address 200 Douglas Building Wichita, Kansas 67202
Character of Well (completed as Oil, Gas or Dry Hole) Dry Hole
Date well completed February 19, 19 82
Application for plugging filed February 19, 19 82
Application for plugging approved February 19, 19 82
Plugging commenced February 19, 19 82
Plugging completed February 19, 19 82
Reason for abandonment of well or producing formation Dry Hole

If a producing well is abandoned, date of last production 19
Was permission obtained from the Conservation Division or its agents before plugging was commenced? Yes

Name of Conservation Agent who supervised plugging of this well Carl Goodrow
Producing formation _____ Depth to top _____ Bottom _____ Total Depth of Well 2380' Feet
Show depth and thickness of all water, oil and gas formations.

OIL, GAS OR WATER RECORDS

CASING RECORD

FORMATION	CONTENT	FROM	TO	SIZE	PUT IN	PULLED OUT
		surface	338'	8 5/8"		

Describe in detail the manner in which the well was plugged, indicating where the mud fluid was placed and the method or methods used in introducing it into the hole. If cement or other plugs were used, state the character of same and depth placed, from _____ feet to _____ feet for each plug set.

1st plug @ 1080' w/70 sx
2nd plug @ 350' w/40 sx
Bridge @ 40' w/10 sx
10 sx in Rat Hole


RECEIVED
STATE CORPORATION COMMISSION

06-14-82 JUN 14 1982

CONSERVATION DIVISION
Wichita, Kansas

Name of Plugging Contractor Sun Oil Well Cementing, Inc.
Address Box 169 Great Bend, Kansas 67530

STATE OF KANSAS, COUNTY OF SEDGWICK, ss.
William R. Horigan (employee of owner) or (owner or operator) of the above-described well, being first duly sworn on oath, says: That I have knowledge of the facts, statements, and matters herein contained and the log of the above-described well as filed and that the same are true and correct. So help me God.

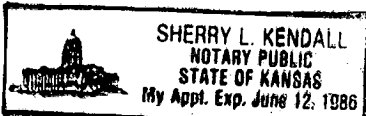

(Signature) William R. Horigan
William R. Horigan 200 Douglas Building
(Address) Wichita, Kansas 67202

SUBSCRIBED AND SWORN to before me this 5th day of June, 19 82

My commission expires 06/12/86 Sherry L. Kendall Notary Public.