

This form shall be filed in duplicate with the Kansas Corporation Commission, 200 Colorado Derby Building, Wichita, Kansas 67202, within ten days after the completion of the well, regardless of how the well was completed.

Attach separate letter of request if the information is to be held confidential. If confidential, only file one copy. Information on side one will be of public record and side two will then be held confidential.

Circle one: Oil, Gas, Dry, SWD, OWWO, Injection. Type and complete ALL sections. Applications must be filed for dual completion, commingling, SWD and injection, T.A.

Attach wireline logs (i.e. electrical log, sonic log, gamma ray neutron log, etc.). KCC # (316) 263-3238. (Rules 82-2-105 & 82-2-125)

OPERATOR Rupe Oil Company, Inc.

API NO. 15-051-22597-00-00

ADDRESS P.O. Box 2273

COUNTY Ellis

Wichita, KS 67201

FIELD

**CONTACT PERSON Bill Clement

PROD. FORMATION

PHONE 316-262-3748

LEASE Ft. Hays State

PURCHASER

WELL NO. 1

ADDRESS

WELL LOCATION NW-NE-NE

DRILLING KANDRILCO, Ltd.

330 Ft. from North Line and

CONTRACTOR Suite 207

660 Ft. from East Line of

ADDRESS 555 North Woodlawn, Bldg. 1

the NE SEC. 7 TWP. 14 RGE. 18W

Wichita, KS 67208


WELL PLAT

PLUGGING Halliburton Services

CONTRACTOR

ADDRESS P.O. Drawer 1431

Duncan, Oklahoma 73536

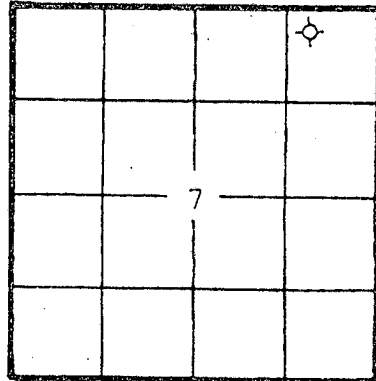

KCC
KGS
(Office Use)

TOTAL DEPTH 3750 RTD PBTD

SPUD DATE 10-12-81 DATE COMPLETED 10-22-81

ELEV: GR 2040 DF KB 2057

DRILLED WITH (CABLE) (ROTARY) (AIR) TOOLS

Amount of surface pipe set and cemented 236' DV Tool Used? NO

AFFIDAVIT

STATE OF KANSAS, COUNTY OF SEDGWICK SS, I,

James L. Crisler OF LAWFUL AGE, BEING FIRST DULY SWORN UPON HIS OATH,

DEPOSES THAT HE IS Geologist (FOR) ~~COX~~ Rupe Oil Co., Inc.

OPERATOR OF THE Ft. Hays State LEASE, AND IS DULY AUTHORIZED TO MAKE

THIS AFFIDAVIT FOR AND ON THE BEHALF OF SAID OPERATOR, THAT WELL NO. 1 ON

SAID LEASE HAS BEEN COMPLETED AS OF THE 22nd DAY OF October, 19 81, AND THAT

ALL INFORMATION ENTERED HEREIN WITH RESPECT TO SAID WELL IS TRUE AND CORRECT.

FURTHER AFFIANT SAITH NOT.

(s) James L. Crisler


Faye W. Leach

NOTARY PUBLIC, Faye W. Leach

SUBSCRIBED AND SWORN BEFORE ME THIS 19th DAY OF April, 19 82.

MY COMMISSION EXPIRES: September 30, 1985

The person who can be reached by phone regarding any questions concerning this information within 45 days of completion, a witnessed initial test by the Commission is required if the well produces more than 25 BOPD or is located in a Basic Order Pool.

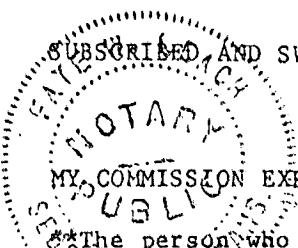

RECEIVED
APR 27 1982
KANSAS CORPORATION COMMISSION
KANSAS DIVISION