


STATE OF KANSAS  
STATE CORPORATION COMMISSION

Form CP-4

Give All Information Completely  
Make Required Affidavit  
Mail or Deliver Report to:  
Conservation Division  
State Corporation Commission  
211 No. Broadway  
Wichita, Kansas

WELL PLUGGING RECORD

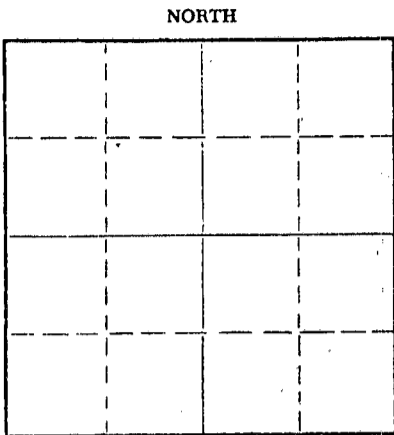

Locate well correctly on above  
Section Plat

Gove County. Sec. 3 Twp. 14 Rge. 27W (E) (W)  
Location as "NE/CNW/SW" or footage from lines C SW NE  
Lease Owner Chief Drilling Co., Inc.  
Lease Name Porter Well No. 1  
Office Address Suite 905 Century Plaza, Wichita, Kansas 67202  
Character of Well (completed as Oil, Gas or Dry Hole) Dry Hole  
Date well completed 12/13/71 19  
Application for plugging filed 12/13/71 19  
Application for plugging approved 12/13/71 19  
Plugging commenced 12/13/71 19  
Plugging completed 12/13/71 19  
Reason for abandonment of well or producing formation Dry Hole

If a producing well is abandoned, date of last production 19  
Was permission obtained from the Conservation Division or its agents before plugging was commenced? Yes

Name of Conservation Agent who supervised plugging of this well W. L. Nichols  
Producing formation Depth to top Bottom Total Depth of Well 2229 Feet  
Show depth and thickness of all water, oil and gas formations.

OIL, GAS OR WATER RECORDS

CASING RECORD

FORMATION	CONTENT	FROM	TO	SIZE	PUT IN	PULLED OUT
		0	267	8 5/8"		

Describe in detail the manner in which the well was plugged, indicating where the mud fluid was placed and the method or methods used in introducing it into the hole. If cement or other plugs were used, state the character of same and depth placed, from feet to feet for each plug set.

Plugged through drill pipe @ 1000' w/110 cu. ft. cement  
Plugged through drill pipe @ 280' w/30 cu. ft. cement  
Plugged through drill pipe @ 40' w/10 cu. ft. cement

RECEIVED  
STATE CORPORATION COMMISSION  
DEC 15 1971  
CONSERVATION DIVISION  
Wichita, Kansas

(If additional description is necessary, use BACK of this sheet)  
Name of Plugging Contractor Chief Drilling Co., Inc.  
Address Suite 905 Century Plaza, Wichita, Kansas 67202

STATE OF KANSAS, COUNTY OF SEDGWICK, ss.  
Lin Robinson (employee of owner) or (owner or operator) of the above-described

well, being first duly sworn on oath, says: That I have knowledge of the facts, statements, and matters herein contained and the log of the above-described well as filed and that the same are true and correct. So help me God.

(Signature) Lin Robinson  
Suite 905 Century Plaza, Wichita, Kansas  
(Address)

SUBSCRIBED AND SWORN TO before me this 14th day of December, 1971

My commission expires August 5, 1975

Virginia S. Fabian Notary Public.

15-063-20096-00-00

WELL LOG

CHIEF DRILLING CO., INC.  
Suite 905 Century Plaza  
Wichita, Kansas 67202

#1 PORTER  
C SW NE Sec. 3-14-27W  
Gove County, Kansas

CONTRACTOR: Company Tools  
CASING RECORD: Set 258' of 8 5/8"  
w/180 sacks Common Quick  
Set Cement

COMMENCED: 12/11/71  
COMPLETED: 12/13/71

<u>FORMATION</u>	<u>FROM</u>	<u>TO</u>	<u>ELEVATION</u>
Rock Sand & Shale	0	266	2574 Gr.
Shale	266	372	2576 D.F.
Sand & Shale	372	1501	2579 K.B.
Shale & Red Bed	1501	1983	
Shale & Shells	1983	2053	
Anhydrite	2053	2092	
Shale	2092	2229	
Total Depth	2229		

FORMATION TOPS:

Anhydrite	2053 + 526
Base Anhy.	2092 + 487
T.D.	2229 + 350

STATE OF KANSAS, COUNTY OF SEDGWICK) ss:

RECEIVED  
STATE CORPORATION COMMISSION  
DEC 17 1971  
CONSERVATION DIVISION  
Wichita, Kansas


I hereby certify that the above is a true and correct copy of the Driller's Log of the well drilled in the C SW NE of Section 3-14-27W, Gove County, Kansas, to the best of my knowledge and belief.

CHIEF DRILLING CO., INC.

*Jim Robinson*

Jim Robinson, Office Manager

Subscribed and sworn to before me this 16th day of December, 1971.

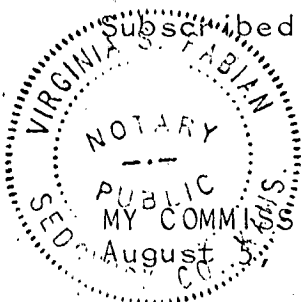

*Virginia S. Fabian*  
Virginia S. Fabian, Notary Public