


WELL PLUGGING RECORD

Give All Information Completely  
Make Required Affidavit  
Mail or Deliver Report to:  
Conservation Division  
State Corporation Commission  
800 Bittling Building  
Wichita, Kansas

Saline County, Sec. 18 Twp. 17 Rge. 2W (E) (W)

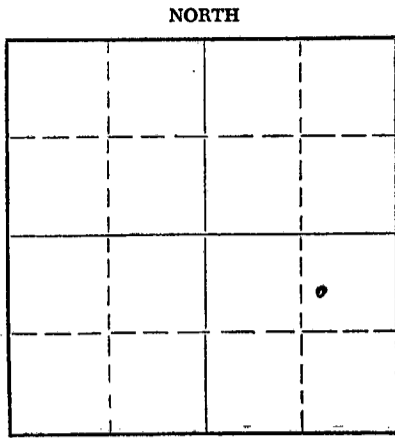

Location as "NE/CNW%SW%" or footage from lines \_\_\_\_\_  
Lease Owner Sheldon Bros.  
Lease Name Sheldon Bros Well No. A-1  
Office Address 425 W. Iron, Salina, Kansas  
Character of Well (completed as Oil, Gas or Dry Hole) Oil  
Date well completed Feb 27 1946  
Application for plugging filed \_\_\_\_\_ 19\_\_\_\_  
Application for plugging approved July 22 1953  
Plugging commenced July 24 1953  
Plugging completed July 31 1953  
Reason for abandonment of well or producing formation Depleted

If a producing well is abandoned, date of last production Nov 17 1952  
Was permission obtained from the Conservation Division or its agents before plugging was commenced? Yes

Name of Conservation Agent who supervised plugging of this well \_\_\_\_\_  
Producing formation Wichita Depth to top 321 3/4' Bottom 321 1/2' Total Depth of Well 321 1/2' Feet  
Show depth and thickness of all water, oil and gas formations.

OIL, GAS OR WATER RECORDS

CASING RECORD

FORMATION	CONTENT	FROM	TO	SIZE	PUT IN	PULLED OUT

Describe in detail the manner in which the well was plugged, indicating where the mud fluid was placed and the method or methods used in introducing it into the hole. If cement or other plugs were used, state the character of same and depth placed, from 3203' feet to 3190' feet for each plug set.


- 7-24-53 Filled hole with sand from 3203' to 3190', dumped 6 sbs. cement. Cleaned out by spider.
- 7-25-53 set sills + jacks, working pipe, unable to get tension enough to remove sills from spider @ 2500 lbs. pressure on jacks. Had spider cut off w/ tension.
- 7-27-53 Wash hole filled with water to 300' of top. Run shot @ 2506' mud down in hole, pumped 16 sbs. mud 1/4 holes. Packed seal, 40 sbs. oil pumped plug to 2500'
- 7-29-53 Pulling Pipe
- 7-30-53 Finished pulling pipe 92 jts. 2521.31', Packed mud down to 175' put in 16' rock dredge. Run 15 sbs. cement.
- 7-31-53 Filled hole with mud from top of cement @ 120' to 20', put in 5' rock dredge. Run 5 sbs. cement, filled to top of surface pipe. Tore down, 16 sbs. cement 300# sand.

(If additional description is necessary, use BACK of this sheet)  
Name of Plugging Contractor Jayhawk Casing Pulling Co.  
Address North of Kansas St. Russell, Kansas.

STATE OF Kansas, COUNTY OF Saline, ss.  
Charles W. Sheldon, operator (employee of owner) or (owner or operator) of the above-described well, being first duly sworn on oath, says: That I have knowledge of the facts, statements, and matters herein contained and the log of the above-described well as filed and that the same are true and correct. So help me God.

(Signature) Charles W. Sheldon, admin.  
425 W. Iron, Salina, Kansas  
(Address)

SUBSCRIBED AND SWORN TO before me this 29 day of Sept, 1953  
May 19 1954  
My commission expires \_\_\_\_\_  
Notary Public.

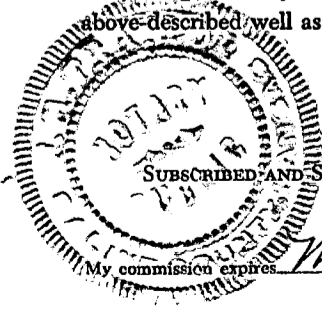

**PLUGGING**  
FILE SEC 18 T 14 R 2W  
BOOK PAGE 42 LINE 2

RECEIVED  
STATE CORPORATION COMMISSION  
10-03-53  
001-31853  
CONSERVATION DIVISION  
Wichita, Kansas