

WELL PLUGGING RECORD

Give All Information Completely
Make Required Affidavit
Mail or Deliver Report to:
Conservation Division
State Corporation Commission
800 Bittling Building
Wichita, Kansas

Saline County. Sec. 18 Twp. 14S Rge. (E)/2 (W)

Location as "NE/CNW $\frac{1}{4}$ SW $\frac{1}{4}$ " or footage from lines NEC NE SE

Lease Owner Frank Jones

Lease Name Loux Well No. 1

Office Address Box 387 McPherson, Kansas

Character of Well (completed as Oil, Gas or Dry Hole) Oil Well

Date well completed 19

Application for plugging filed 10-4-50 19

Application for plugging approved 10-4-50 19


Plugging commenced 9-30-50 19

Plugging completed 10-4-50 19

Reason for abandonment of well or producing formation Depleted supply

If a producing well is abandoned, date of last production 19

Was permission obtained from the Conservation Division or its agents before plugging was commenced? Yes

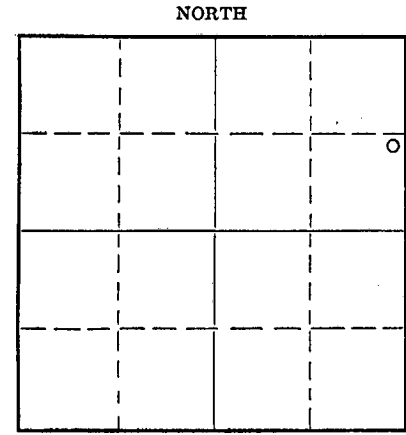

Locate well correctly on above Section Plat

Name of Conservation Agent who supervised plugging of this well C. D. Stough

Producing formation Depth to top Bottom Total Depth of Well 3270 Feet

Show depth and thickness of all water, oil and gas formations.

OIL, GAS OR WATER RECORDS

CASING RECORD

Formation	Content	From	To	Size	Put In	Pulled Out

Describe in detail the manner in which the well was plugged, indicating where the mud fluid was placed and the method or methods used in introducing it into the hole. If cement or other plugs were used, state the character of same and depth placed, from feet to feet for each plug set.

Surface pipe 8 5/8" - 184 ft. circulated with cement.
5 1/2 casing set at 3256 ft. cemented. Plugged back to 3250 ft. with mud -- set rock bridge and dumped 5 sacks of cement at 3250 ft. Ripped off and pulled the 5 1/2 casing--filled with mud to 184 ft. set rock bridge and 15 sacks of cement at 184 ft. Mud to 30 ft. bridge and 10 sacks of cement at the surface.

(If additional description is necessary, use BACK of this sheet)


Correspondence regarding this well should be addressed to Frank Jones
Address McPherson, Kansas

STATE OF _____, COUNTY OF _____, ss.

(employee of owner) or (owner or operator) of the above-described well, being first duly sworn on oath, says: That I have knowledge of the facts, statements, and matters herein contained and the log of the above-described well as filed and that the same are true and correct. So help me God.

(Signature) Frank Jones
McPherson, Kansas
(Address)

SUBSCRIBED AND SWORN to before me this 16 day of October, 1950

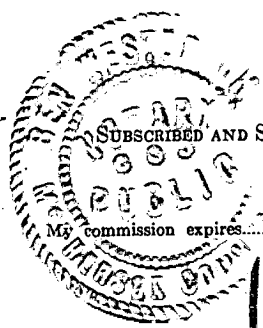

Ben Wertz
Notary Public.
RECEIVED
STATE CORPORATION COMMISSION
OCT 17 1950
10-17-1950
CONSERVATION DIVISION
Wichita, Kansas

PLUGGING
FILE SEC 18 T 14 R 200
BOOK PAGE 38 LINE 12

15-169-00774-00-00

WELL LOG LOUX NO. 1

Globe Oil & Refining Co. - Lease Owners

Sec. 18, Twp. 14, Range 2W

Donald T. Ingling - Contractor

Location: NE/4 NE/4 SE/4

Total Depth: 3257' (Rotary)

County: Saline (Kansas)

Commenced: September 19, 1945

Elevation: 1276'

Completed: October 6, 1945 (Rotary)

Casing: 200' of 8 5/8"

Production: 519 bbls.

~~3257' of 5-1/2"~~

Figures below indicate bottom of formation:

175 Surface
230 Lime
425 Lime & Sand
565 Lime & Anhydrite
620 Lime & Sand
635 Sand
735 Sand & Shale
950 Lime & Shale
1475 Shale
1660 Shale & Shells
1825 Lime & Shale
1885 Broken Lime
2060 Shale & Lime
2070 Lime
2170 Lime & Shale
2235 Lime
2315 Broken Lime-Shale
2440 Lime & Shale
2480 Shale

2535 Lime & Shale
2715 Shale
2745 Shale & Lime
2760 Shale & Chert
2830 Chat
2875 Shale & Chert (Streaks)
2905 Chat & Cherty Lime
2935 Lime
2965 Lime & Shale
3070 Shale
3135 Lime
3175 Lime & Shale
3235 Lime
3253 Shale
3257 Viola
3257 TOTAL DEPTH

3270 Viola - T.D

PLUGGING
FILE SEC 18 T 14 R 2W
ROCK PAGE 38 LINE 12

RECEIVED
STATE CORPORATION COMMISSION
OCT 17 1950
CONSERVATION DIVISION
Wichita, Kansas
10-17-1950