

WELL PLUGGING RECORD

Give All Information Completely
Make Required Affidavit
Mail or Deliver Report to:
Conservation Division
State Corporation Commission
211 No. Broadway
Wichita, Kansas

Saline County, Sec. 18 Twp. 14S Rge. 2W (E) (W)

Location as "NE/CNW/SW" or footage from lines NE/4

Lease Owner Charles W. Sheldon Et al

Lease Name Marymount Well No. 1

Office Address 340 West Beloit - Salina, Kansas

Character of Well (completed as Oil, Gas or Dry Hole) Oil well

Date well completed April 8 1957

Application for plugging filed March 21 1957

Application for plugging approved March 27 1957


Plugging commenced May 15 1957

Plugging completed May 19 1957

Reason for abandonment of well or producing formation Condemed by state City of Salina, Kans. for Salina Flood Control system

If a producing well is abandoned, date of last production April 27 1957

Was permission obtained from the Conservation Division or its agents before plugging was commenced? Yes

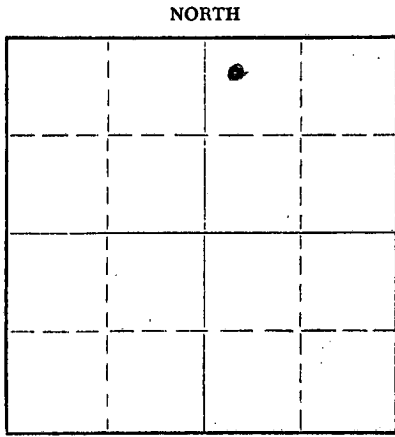

Locate well correctly on above Section Plat

Name of Conservation Agent who supervised plugging of this well Ruel Durkee

Producing formation hiola Depth to top 3169' Bottom 3171' Total Depth of Well 3171 Feet

Show depth and thickness of all water, oil and gas formations.

OIL, GAS OR WATER RECORDS

CASING RECORD

FORMATION	CONTENT	FROM	TD	SIZE	PUT IN.	PULLED OUT
				8-5/8"	161'	None
				5-1/2"	3170'	2656'

Describe in detail the manner in which the well was plugged, indicating where the mud fluid was placed and the method or methods used in introducing it into the hole. If cement or other plugs were used, state the character of same and depth placed, from _____ feet to _____ feet for each plug set.

Filled the hole with sand from 3171' to 3160' and ran 6 sacks of cement. Mudded the hole to 160', set a 10' rock bridge and ran 10 sacks of cement on bridge. Bailed hole dry and ran 50 sacks of cement to fill 8-5/8" surface casing to within 10' of top. Plugging completed.

(If additional description is necessary, use BACK of this sheet)

Name of Plugging Contractor West Supply Co., Inc.
Address Chase, Kansas

STATE OF Kansas COUNTY OF Saline, ss.
Charles W. Sheldon, operator (employee of owner) or (owner or operator) of the above-described well, being first duly sworn on oath, says: That I have knowledge of the facts, statements, and matters herein contained and the log of the above-described well as filed and that the same are true and correct. So help me, God.

(Signature) Charles W. Sheldon, operator
1022 No. Santa Fe, Salina, Kans. (Address)



SUBSCRIBED AND SWORN TO before me this 10 day of June, 1957
My commission expires May 19-1958

RECEIVED
STATE CORPORATION COMMISSION

PLUGGING
FILE SEC 18 T 14 R 2W
BOOK PAGE 1 LINE 25

JUN 11 1957
06-11-1957
CONSERVATION DIVISION
Wichita, Kansas

15-169-00777-00-00

Charles W. Sheldon Et al - Marymount #1 -- Day Work

Date	Day Work	Remarks
5-15-57	7 Hrs.	Checked the hole and found it open. Filled the hole with sand from 3170' to 3160' and ran 6 sacks of cement. Cleaned the cellar. Took tension on casing and had 5". Loaded the hole with water.
5-16-57	0 "	Did not work.
5-17-57	7 "	Checked the hole and it was open. Shot casing at 2793' and was still in the cement. Shot casing at 2680' and worked it to 26" tension. Shot casing at 2653' where it came loose. Pulled 40 joints.
5-18-57	7 "	Pulled 44 joints of casing. Filled the hole with mud to 160', set a 10' rock bridge and ran 10 sacks of cement.
5-19-57	7 "	Bailed off fluid. Mixed and ran 50 sacks of cement to fill 8-5/8" surface casing to within 10' of top.

Plugging completed

PLUGGING	
SEC 18 T 14 2W	
BOOK PAGE 1	LINE 25