

STATE OF KANSAS
STATE CORPORATION COMMISSION


Give All Information Completely
Make Required Affidavit
Mail or Deliver Report to:
Conservation Division
State Corporation Commission
211 No. Broadway
Wichita, Kansas

15-051-00838-00-00
WELL PLUGGING RECORD

Ellis County, Sec. 18 Twp. 14 Rge. (E) 17 (W)

Location as "NE/CNW%SW%" or footage from lines SW SW NE
Lease Owner Goppinger Drilling, Inc.
Lease Name Stecklein Well No. 1
Office Address 507 Union National Building, Wichita, Kansas
Character of Well (completed as Oil, Gas or Dry Hole) Dry Hole
Date well completed November 30, 19 56
Application for plugging filed November 30, 19 56
Application for plugging approved November 30, 19 56
Plugging commenced November 30, 19 56
Plugging completed November 30, 19 56
Reason for abandonment of well or producing formation Dry Hole

NORTH

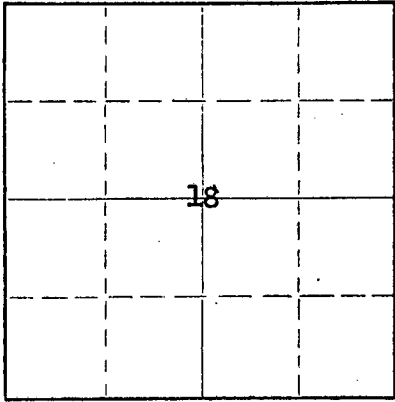

Locate well correctly on above Section Plat

If a producing well is abandoned, date of last production _____ 19____
Was permission obtained from the Conservation Division or its agents before plugging was commenced? Yes

Name of Conservation Agent who supervised plugging of this well Mr. Eldon Petty
Producing formation _____ Depth to top _____ Bottom _____ Total Depth of Well 3572 Feet
Show depth and thickness of all water, oil and gas formations.

OIL, GAS OR WATER RECORDS

CASING RECORD

FORMATION	CONTENT	FROM	TO	SIZE	PUT IN	PULLED OUT
				8 5/8"	255'	None

Describe in detail the manner in which the well was plugged, indicating where the mud fluid was placed and the method or methods used in introducing it into the hole. If cement or other plugs were used, state the character of same and depth placed, from _____ feet to _____ feet for each plug set.

Cemented 250' of 8 5/8" w/80 sax cement. Pumped down under pressure with Halliburton Oil Well Cementing Co.

(If additional description is necessary, use BACK of this sheet)

Name of Plugging Contractor Goppinger Drilling, Inc.
Address 507 Union National Bank Building, Wichita, Kansas

STATE OF Kansas, COUNTY OF Sedgwick, ss.
Lee Poulsen, Geologist of the above-described well, being first duly sworn on oath, says: That I have knowledge of the facts, statements, and matters herein contained and the log of the above-described well as filed and that the same are true and correct. So help me God.

(Signature) Lee Poulsen
507 Union National Bank Building, Wichita, Ks.
(Address)

SUBSCRIBED AND SWORN TO before me this 3rd day of December, 19 56

My commission expires March 7, 1960

Mayree Broadus
Notary Public.

PLUGGING
FILE SEC. 18 T. 14 R. 17W
BOOK PAGE 121 LINE 23

RECEIVED
12-04-1956
CONSERVATION COMMISSION
Wichita, Kansas

15-051-00838-00-00

MULLERS LOG

Coppinger Drilling, Inc.
Wichita, Kansas

Drilling No. 1
Location
Date

#1 Stecklein
SW SW NE Sec. 18-14-17W
Ellis County, Kansas

Casing Record

8 5/8" casing @ 255 w/150 sxc cement

Sand	88
Shale	447
Sand & Shale	7.5
Red Beds & Shale	1185
Anhydrite	1225
Shale	1285
Shale & Shells	1500
Shale	1560
Shale & Salt	1650
Lime & Shale	2225
Lime	2365
Lime & Shale	2530
Lime	2590
Shale & Lime	2650
Shale	2825
Lime & Shale	3040
Lime	3115
Lime & Shale	3170
Heebner	3236
Lime	3245
Lime & Shale	3360
Lime	3404
Lime & Shale	3452
Lime	3493
Lime & Shale	3540
Lime	3572

Sample Tests

Heebner	3233
Toronto	3250
Lansing	3278
Base-Kansas City	3502
Conglomerate	3518
Arboucke	3547
R.T.D.	3572

State of Kansas) ss.
County of Sedgwick)

I hereby certify that the foregoing is a true and correct log of the #1 Stecklein drilled at the above location by Coppinger Drilling, Inc., to the best of my knowledge and belief.

Lee Paulsen
Lee Paulsen, Geologist

Mayres Broadus
(Mayres Broadus) Notary Public

Subscribed and sworn to before me, a notary public, this 3rd day of December, 1956.
My commission expires: March 1960

RECEIVED
STATE CORPORATION COMMISSION

PLUGGING
FILE NO. SEC. 18 T. 14 R. 17W
BOOK PAGE 127 LINE 23

DEC 4 - 1956
18-04-1956
CONSERVATION DIVISION
Wichita, Kansas