15-051-23541-00-00

Form CP-4
Rev. 12-15-80

STATE OF KANSAS
STATE CORPORATION COMMISSION
200 Colorado Derby Bldg.
Wichita, Kansas 67202

WELL PLUGGING RECORD

Give All Information Completely
Make Required Affidavit

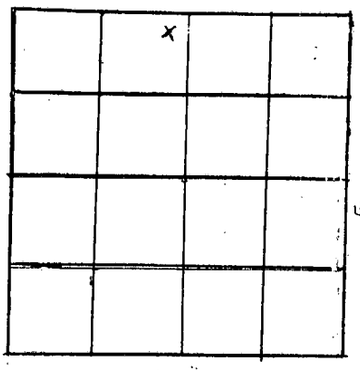

Locate Well correctly on above Section Platt.

COUNTY Ellis SEC. 12 TWP. 14 RGE. 17 E/W
Location as in quarters or footage from lines:
N/2 NW NW NE
Lease Owner Star II Oil Company
Lease Name Brungardt Well No. B-1
Office Address Box 56, Victoria, Kansas 67671
Character of Well (Completed as Oil, Gas or Dry Hole): Dry Hole (a)(c)
Date Well Completed 7-23-83
Application for plugging filed 7-23-83
Plugging commenced 7-23-83
Plugging completed 7-24-83
Reason for abandonment of well or producing formation Dry Hole

Was permission obtained from the Conservation Division or it's Agent's before plugging was commenced? Yes

Name of Conservation Agent who supervised plugging of this well Dale Balthazor
Producing formation _____ Depth to top _____ bottom -- T.D. 3550'
Show depth and thickness of all water, oil and gas formations.

OIL, GAS OR WATER RECORDS — Casing Record

Formation	Content	From	To	Size	Put in	Pulled Out
		0	245'	8-5/8"	245'	None

Describe in detail the manner in which the well was plugged, indicating where the mud fluid was placed and the method or methods used in introducing it into the hold. If cement or other plugs were used, state the character of same and depth placed, from _____ feet to _____ feet for each plug set. 170 sks 50/50 Poz, 6% Gel, 3% CC:
25 sks @ 3480'
25 sks @ 1100'
100 sks @ 470'
10 sks @ 40'
10 sks in rathole
By Halliburton
Completed 7-24-83; 3:00 a.m.

RECEIVED
STATE CORPORATION COMMISSION
8-09-1983
AUG 09 1983
CONSERVATION DIVISION
Wichita, Kansas

(If additional description is necessary, use BACK of this sheet)
Name of Plugging Contractor Allen Drilling Company

STATE OF KANSAS COUNTY OF BARTON, ss.
Dale L. Smith (employee of owner), or (~~owner or operator~~) of the above-described well, being first duly sworn on oath, says: That I have knowledge of the facts, statements, and matters herein contained and the log of the above-described well as filed and that the same are true and correct. So help me God.

(Signature) Dale L. Smith
Box 1389, Great Bend, Kansas 67530
(Address)

SUBSCRIBED AND SWORN TO before me this 28th day of July, 1983

ULANDA NICHOLS NOTARY PUBLIC BARTON COUNTY, KANSAS

Ulanda Nichols
Notary Public.

My commission expires: 12-10-83

RECEIVED
STATE CORPORATION COMMISSION
AUG 09 1983
CONSERVATION DIVISION
Wichita, Kansas