


WELL PLUGGING RECORD

- Give All Information Completely
- Make Required Affidavit
- Mail or Deliver Report to:  
Conservation Division  
State Corporation Commission  
800 Bittling Building  
Wichita, Kansas

Ellis County County. Sec. 9 Twp. 14S Rge. 17 (E) W (W) W

Location as "NE/CNW/SW" or footage from lines SESESW Sec. 9-14S-17W  
Lease Owner Leben Oil Producers  
Lease Name Lang Well No. 1  
Office Address 116 1/2 West Central, El Dorado, Kansas  
Character of Well (completed as Oil, Gas or Dry Hole) Dry  
Date well completed January 30 1955  
Application for plugging filed January 30 1955  
Application for plugging approved January 30 1955  
Plugging commenced January 30 1955  
Plugging completed January 30 1955  
Reason for abandonment of well or producing formation Dry Hole

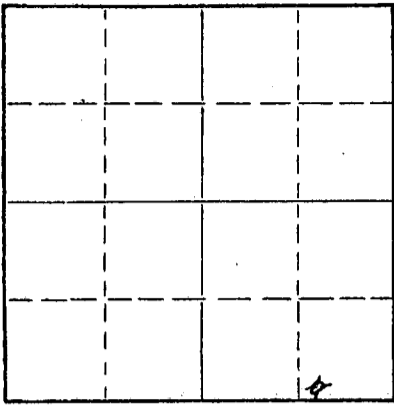

Locate well correctly on above Section Plat

If a producing well is abandoned, date of last production \_\_\_\_\_ 19\_\_\_\_  
Was permission obtained from the Conservation Division or its agents before plugging was commenced? Yes

Name of Conservation Agent who supervised plugging of this well Eldon Petty  
Producing formation \_\_\_\_\_ Depth to top \_\_\_\_\_ Bottom \_\_\_\_\_ Total Depth of Well 3617 Feet  
Show depth and thickness of all water, oil and gas formations.

OIL, GAS OR WATER RECORDS

CASING RECORD

FORMATION	CONTENT	FROM	TO	SIZE	PUT IN	PULLED OUT
				8 5/8	150'	

Describe in detail the manner in which the well was plugged, indicating where the mud fluid was placed and the method or methods used in introducing it into the hole. If cement or other plugs were used, state the character of same and depth placed, from \_\_\_\_\_ feet to \_\_\_\_\_ feet for each plug set.

Filled hole with rotary mud  
8 5/8" plug on mud. Cemented  
with 80 sacks of cement.

Name of Plugging Contractor Leben Drilling Company (If additional description is necessary, use BACK of this sheet)  
Address El Dorado, Kansas

STATE OF Kansas, COUNTY OF Butler, ss.  
Loren L. Kellogg (employee of owner) or (owner or operator) of the above-described well, being first duly sworn on oath, says: That I have knowledge of the facts, statements, and matters herein contained and the log of the above-described well as filed and that the same are true and correct. So help me God.

(Signature) Loren L. Kellogg  
El Dorado, Kansas (Address)

SUBSCRIBED AND SWORN TO before me this 7th day of February, 1955

Paul D. Randolph Notary Public.

My commission expires May 1, 1958



**PLUGGING**  
FILE SEC 9-14-17W  
BOOK PAGE 94 LINE 16

FILED  
ON COMMISSION  
FEB 3 1955  
02-08-1955  
DIVISION

CONTRACTOR'S WELL LOG

COMPANY:  
CONTRACTOR:  
FARM:  
LOCATION:  
  
COMMENCED:  
COMPLETED:

Leben Oil Producers  
Leben Drilling Company  
Lang #1  
SE SE SW Sec. 9-14S-17W  
Ellis County, Kansas  
1-19-55  
1-30-55

0	40	Top soil & sand
40	151	Shale, W/lime
151	495	Shale, shells
495	585	Sand
585	675	Shale, sand
675	1180	Shale
1180	1181	Shale
1181	1219	Lime
1219	1360	Red Bed, shale
1360	1725	Shale, Shells
1725	1856	Shale, lime
1856	1947	Lime, shale
1947	2180	Shale, shells
2180	2279	Lime
2279	2374	Lime
2374	2486	Lime, shale
2486	2575	Lime, shale
2575	2722	Lime, shale
2722	2850	Shale, lime
2850	2951	Lime, shale
2951	3010	Lime, shale
3010	3099	Lime, shale
3099	3163	Lime, shale
3163	3217	Lime, shale
3217	3268	Lime, shale
3268	3335	Lime
3335	3385	Lime
3385	3430	Lime
3430	3483	Lime
3483	3524	Lime
3524	3534	Lime
3534	3538	Lime
3538	3563	Lime
3563	3573	
3573	3604	Lime, shale
3604	3617	Rotary Total Depth. Dry.

Set 8 5/8" surface at 150'. Used 100 sacks Poz Mix and 2 sacks C. C.

I, Loren L. Kellogg, do hereby certify that the above and foregoing is a true and correct copy of the log of the Lang #1, SE SE SW Sec. 9-14S-17W, Ellis County, Kansas, as reflected by the files of the Leben Drilling Company.

LEBEN DRILLING COMPANY  
*Loren L. Kellogg*  
Loren L. Kellogg, Off. Mgr.

STATE OF KANSAS )  
COUNTY OF BUTLER ) SS

Subscribed and sworn to before me, a Notary Public, in and for Butler County, Kansas, this 7th day of February, 1955.

*Paul D. Randall*  
NOTARY PUBLIC

My commission expires May 1, 1958.

**PLUGGING**  
MIX 9 1/4 220  
WATER 94 LBS 16

**RECEIVED**  
STATE CORPORATION COMMISSION  
APR 4 1955  
04-04-1955  
CONSERVATION DIVISION  
Wichita