

WELL PLUGGING RECORD

Give All Information Completely
Make Required Affidavit
Mail or Deliver Report to:
Conservation Division
State Corporation Commission
800 Bittig Building
Wichita, Kansas

SW/SW/SE/ 20, 18, 42W

Greeley County. Sec. Twp. Rge. (E) (W)

Location as "NE/CNW $\frac{1}{4}$ SW $\frac{1}{4}$ " or footage from lines 330 from SW corner

Lease Owner Duncan Drilling Co.

Lease Name Aron Sell Well No. 1

Office Address Box 109 Big Spring, Texas.

Character of Well (completed as Oil, Gas or Dry Hole) Dry hole

Date well completed 9-9-51 19

Application for plugging filed 9-9-51 19

Application for plugging approved 9-11-51 19


Plugging commenced 9-11-51 19

Plugging completed 9-12-51 19

Reason for abandonment of well or producing formation dry hole

If a producing well is abandoned, date of last production 19

Was permission obtained from the Conservation Division or its agents before plugging was commenced? yes File 108 43

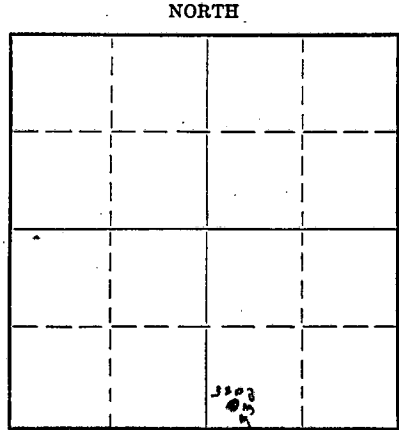

Locate well correctly on above Section Plat

Name of Conservation Agent who supervised plugging of this well Dist. Supt.

Producing formation none Depth to top Bottom Total Depth of Well 5170 Feet

Show depth and thickness of all water, oil and gas formations.

OIL, GAS OR WATER RECORDS

CASING RECORD

Formation	Content	From	To	Size	Put In	Pulled Out
Shale	Surface	0	365 ft.	9 5/8"	365 ft.	Circ. Sement

Describe in detail the manner in which the well was plugged, indicating where the mud fluid was placed and the method or methods used in introducing it into the hole. If cement or other plugs were used, state the character of same and depth placed, from feet to feet for each plug set.

Halliburton method used 20 sks cement on bottom

RECEIVED
STATE CORPORATION COMMISSION
10-15-51
OCT 15 1951

Name of Plugging Contractor Duncan Drilling Co. (If additional description is necessary, use BACK of this sheet)
Address Box 109 Big Spring, Texas. CONSERVATION DIVISION Wichita, Kansas

STATE OF Texas, COUNTY OF Howard, ss. Dave Duncan (Partner) (employee of owner) or (owner or operator) of the above-described well,

being first duly sworn on oath, says: That I have knowledge of the facts, statements, and matters herein contained and the log of the above-described well as filed and that the same are true and correct. So help me God.

(Signature) Dave Duncan Dave Duncan

Box 109 Big Spring, Texas. (Address)

SUBSCRIBED AND SWORN TO before me this 12 day of Oct. 19 51

My commission expires June 1, 1953

M.H. Carroll Notary Public.

PLUGGING
FILE SEC 20 T 18 R 42W
BOOK PAGE 107 LINE 43

15.071.00013.0000

Duncan Drilling Co.
Box 109
Big Spring, Texas.

Formation record: Aron Sell No. 1 SW/SW/SE, 20, 18, 42 W Greeley County, Kan.

Formation	Top	Bottom
Soil, shale	0 ft.	365 ft. Run 365 ft. 9 5/9"
Sandy shale	365	1179
Lime a shale	1179	1555
Lime and Anhydrite	1555	1600
Shale and lime	1600	1905
Shale and red rock	1905	2330
Lime and anhydrite	2330	3285
Sandy lime	3285	3384
Lime	3384	5170 TD solid lime, no show

Duncan Drilling Co.

By *Dave Duncan*

Partner

RECEIVED
STATE CORPORATION COMMISSION

OCT 15 1951

CONSERVATION DIVISION
Wichita, Kansas

FILE SEC 20 T 18 42 W
BOOK PAGE 109 LINE 43