

WELL PLUGGING RECORD

Give All Information Completely
Make Required Affidavit
Mail or Deliver Report to:
Conservation Division
State Corporation Commission
211 No. Broadway
Wichita, Kansas

Greeley County, Sec. 5 Twp. 18S Rge. 41 (E) (W)

Location as "NE/CNW/SW" or footage from lines C NW SW

Lease Owner Alfred Ainsworth

Lease Name Wheeler Well No. 1

Office Address 715 Fourth Nat'l Bank Bldg., Wichita, Kansas

Character of Well (completed as Oil, Gas or Dry Hole) Dry hole

Date well completed 10-11 19 64

Application for plugging filed 10-11 19 64

Application for plugging approved 10-11 19 64


Plugging commenced 10-11 19 64

Plugging completed 10-11 19 64

Reason for abandonment of well or producing formation None

If a producing well is abandoned, date of last production 19

Was permission obtained from the Conservation Division or its agents before plugging was commenced? Yes

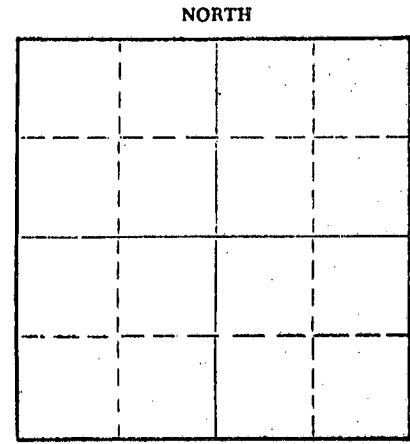

Locate well correctly on above Section Plat

Name of Conservation Agent who supervised plugging of this well

Producing formation Depth to top Bottom Total Depth of Well 5290 Feet

Show depth and thickness of all water, oil and gas formations.

OIL, GAS OR WATER RECORDS

CASING RECORD

FORMATION	CONTENT	FROM	TO	SIZE	PUR IN	PULLED OUT
		0	165	8 5/8	165	-0-

Describe in detail the manner in which the well was plugged, indicating where the mud fluid was placed and the method or methods used in introducing it into the hole. If cement or other plugs were used, state the character of same and depth placed, from feet to feet for each plug set.

Filled hole with mud to 660',
plug, 20 sks. cement. Mud
to 240', plug, 20 sks. cement.
Mud to 40', plug, 10 sks. cement.

RECEIVED
STATE CORPORATION COMMISSION

OCT 21 1964
10-21-64
CONSERVATION DIVISION
Wichita, Kansas

(If additional description is necessary, use BACK of this sheet)

Name of Plugging Contractor Terrel Drilling and Producing

Address Box 606, Russell, Kansas

STATE OF KANSAS COUNTY OF RUSSELL, ss.

Joseph K. Branum (employee or owner or operator) of the above-described well, being first duly sworn on oath, says: That I have knowledge of the facts, statements, and matters herein contained and the log of the above-described well as filed and that the same are true and correct. So help me God.

(Signature) *J. K. Branum*

Box 606, Russell, Kansas (Address)

to before me this 12th day of October, 19 64

L. Lee Simpson
Notary Public.

My commission expires 12-12-66

RECEIVED
STATE CORPORATION COMMISSION

OCT 21 1964

CONSERVATION DIVISION
Wichita, Kansas

W E L L L O G

15-071-00026-0000

OPERATOR: Alfred Ainsworth
715 - 4th Nat'l Bank Bldg.
Wichita, Kansas

CONTRACTOR: Terrel Drilling & Producing
Box 606
Russell, Kansas

LEASE: Wheeler #1

COMMENCED: September 7, 1964

LOCATION: C NW SW, Sec. 5-18S-41W
Greeley County, Kansas

COMPLETED: October 11, 1964

DEPTHS & FORMATIONS

Sand & Shale	284	Lime	3531
Shale	1102	Lime & Shale	3624
Shale & Lime	1605	Lime	5005
Red Bed & Shale	2255	Lime & Shale	5100
Shale	2455	Lime (R.T.D.)	5290
Shale & Lime	2550		


STATE OF KANSAS)
)
COUNTY OF RUSSELL) ss...

Joe K. Branum, owner of Terrel Drilling and Producing, being first duly sworn on oath says: "That I have knowledge of the facts, statements and matters herein contained and the log of the above described well as filed and that the same are true and correct."



Joe K. Branum - TERREL DRILLING AND PRODUCING

Subscribed and sworn before me this 12th day of October, 1964.



Notary Public

My Commission Expires December 12, 1966.

