


STATE OF KANSAS
STATE CORPORATION COMMISSION

WELL PLUGGING RECORD

Give All Information Completely
Make Required Affidavit
Mail or Deliver Report to
Conservation Division
State Corporation Comm.
245 North Water
Wichita, KS 67202

Greeley County. Sec. 35 Twp. 18S Rge. 40 E/W
Location as "NE/CNW $\frac{1}{4}$ SW $\frac{1}{4}$ " or footage from lines 990'FNL & 990'FWL
Lease Owner Wayman W. Buchanan
Lease Name Helm Well No. 3
Office Address 400 Bldg. of the SW, Midland, Texas 79701
Character of Well (Completed as Oil, Gas or Dry Hole) dry hole

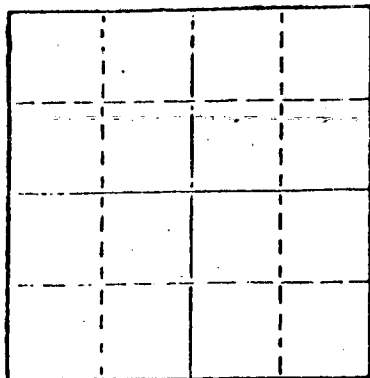

Locate well correctly on above
Section Plat

Date Well completed 5-26-1979
Application for plugging filed 5-26-1979
Application for plugging approved 5-26-1979
Plugging commenced 5-26-1979
Plugging completed 5-26-1979
Reason for abandonment of well or producing formation
no commercial quantities of oil or gas encountered
If a producing well is abandoned, date of last production
-- 19

Was permission obtained from the Conservation Division or
its agents before plugging was commenced? yes

Name of Conservation Agent who supervised plugging of this well Gerald Hoffhauser
Producing formation _____ Depth to top _____ Bottom _____ Total Depth of Well 2928
Show depth and thickness of all water, oil and gas formations.

OIL, GAS OR WATER RECORDS

CASING RECORD

FORMATION	CONTENT	FROM	TO	SIZE	PUT IN	PULLED OUT
surface hole	shale	surf	256'	8-5/8"	246'	none

Describe in detail the manner in which the well was plugged, indicating where the mud fluid was placed and the method or methods used in introducing it into the hold. If cement or other plugs were used, state the character of same and depth placed, from _____ feet to _____ feet for each plug set.

Fluid to 1010', plug, 70 sx
Fluid to 240', plug, 20 sx
Fluid to 40', plug, 10 sx
Rat hole 5 sx

RECEIVED
STATE CORPORATION COMMISSION

JUN - 5 1979
6-5-79

CONSERVATION DIVISION
Wichita, Kansas

(If additional description is necessary, use BACK of this form)
Name of Plugging Contractor D N B DRILLING, INC.
515 R. H. Garvey Building
Wichita, Kansas 67202


STATE OF Kansas COUNTY OF Sedgwick, ss.
Ella Priess (employee of owner) or (owner or operator)
of the above-described well, being first duly sworn on oath, says: That I have knowledge of the facts, statements, and matters herein contained and the log of the above-described well as filed and that the same are true and correct. So help me God.

(Signature) Ella Priess
515 R.H. Garvey Bldg., Wichita, Ks. 67202
(Address)

SUBSCRIBED AND SWORN TO before me this 29th day of May, 19 79

Dorothy L. Schmidt
Dorothy L. Schmidt Notary Public.

My commission expires April 30, 1983

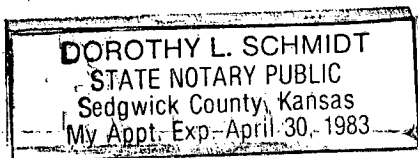

DRILLER'S LOG

WAYMAN W. BUCHANAN
No. 3 Helm
990' FNL & 990' FWL
Sec. 35-18S-40W
Greeley Co., Ks.

Commenced: 5-22-79
Completed: 5-26-79

Surface Casing: 246' of 8-5/8"
cmtd w/250 sx Type H, 3% cc

FORMATION

DEPTH

Surface Hole	0 - 256
Sand & Shale	256 - 1860
Shale & Lime	1860 - 2575
Lime & Shale	2575 - 2830
Lime	2830 - 2928 RTD

I do hereby certify that the foregoing statements are true and correct to the best of my knowledge and belief.

D N B DRILLING, INC.

Ella Priess

Ella Priess

STATE OF KANSAS: ss:

Subscribed and sworn to before me this 29th day of May, 1979.

Dorothy L. Schmidt

Dorothy L. Schmidt, Notary Public

[Faint, illegible stamp]

RECEIVED
STATE CORPORATION COMMISSION

JUN - 5 1979

CONSERVATION DIVISION
Wichita, Kansas

DOROTHY L. SCHMIDT
STATE NOTARY PUBLIC
Sedgwick County, Kansas
My Appt. Exp. April 30, 1983