

15-051-03848-00-00


Give All Information Completely
Make Required Affidavit
Mail or Deliver Report to:
Conservation Division
State Corporation Commission
211 No. Broadway
Wichita, Kansas

WELL PLUGGING RECORD

Ellis County, Sec. 17 Twp. 14 Rge. 16 (E) W (W)
NW NW NW

Location as "NE/CNWxSWx" or footage from lines.
Lease Owner Shields Oil Producers, Inc.
Lease Name Kuhn Well No. One
Office Address Shields Building, Russell, Kansas
Character of Well (completed as Oil, Gas or Dry Hole) Dry hole
Date well completed June 22 19 64
Application for plugging filed June 22 19 64
Application for plugging approved June 22 19 64
Plugging commenced June 22 19 64
Plugging completed June 22 19 64
Reason for abandonment of well or producing formation Dry hole

NORTH

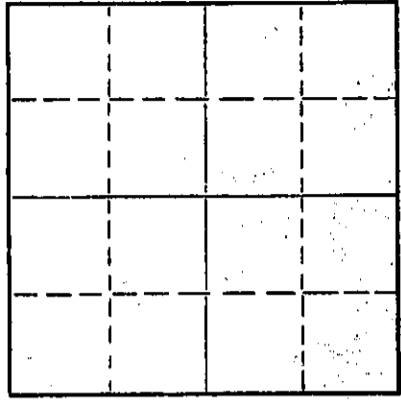

Locate well correctly on above Section Plat

If a producing well is abandoned, date of last production _____ 19____
Was permission obtained from the Conservation Division or its agents before plugging was commenced? Yes

Name of Conservation Agent who supervised plugging of this well Eldon Petty
Producing formation _____ Depth to top _____ Bottom _____ Total Depth of Well 3,448 Feet
Show depth and thickness of all water, oil and gas formations.

OIL, GAS OR WATER RECORDS

CASING RECORD

FORMATION	CONTENT	FROM	TO	SIZE	PUT IN	PULLED OUT
				8 5/8"	215'	Cmtd w/150 sax

Describe in detail the manner in which the well was plugged, indicating where the mud fluid was placed and the method or methods used in introducing it into the hole. If cement or other plugs were used, state the character of same and depth placed, from _____ feet to _____ feet for each plug set.

Fill w/heavy mud to 450'
Set bridge plug @450'
Dump 20 sax cement on plug thru 4 1/2" drill pipe
Set bridge plug @200'
Dump 20 sax cement on plug thru 4 1/2" drill pipe
Set bridge plug @40' w/ 1/2 sax hulls on plug
Dump 10 sax cement on plug to cellar

RECEIVED
STATE CORPORATION COMMISSION

JUL 1 1964

07-01-64
CONSERVATION DIVISION
Wichita, Kansas

(If additional description is necessary, use BACK of this sheet)

Name of Plugging Contractor Shields Drilling Company, Inc.
Address Shields Building, Russell, Kansas

STATE OF Kansas COUNTY OF Russell, ss.
R. L. Shields (Employee or owner) or (owner or operator) of the above-described

well, being first duly sworn on oath, says: That I have knowledge of the facts, statements, and matters herein contained and the log of the above-described well as filed and that the same are true and correct. So help me God.

(Signature) R. L. Shields, Pres.
Shields Building, Russell, Kansas
(Address)

SUBSCRIBED AND SWORN to before me this 29th day of June, 19 64

My commission expires January 31, 1968

Agnes M. Appel
Notary Public.



Shields


15-051-03848-00-00

Russell, Kansas

WELL LOG

Operator: Shields Oil Producers, Inc.
Well: Kuhn #1
Commenced: June 15, 1964
Completed: June 22, 1964
Contractor: Shields Drilling Co., Inc.

Well Description: NW NW NW

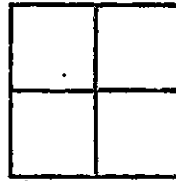

Sec. 17-14S-16W
Ellis County, Kansas

Elevation: 1,920' RB

Treatment:

Production: D & A

Tops: Heebner 3,134'
Toronto 3,152'
Lansing-KC 3,182'
Congl. 3,420'
Arbuckle 3,443'

CASING RECORD

Size Run Pulled
8 5/8" 215' Cmtd w/150 Sax

..... Figures Indicate Bottom of Formations

Clay and shale 215'
Shale and shells 590'
Sand 690'
Shale and shells 1,052'
Anhydrite 1,091'
Shale and shells 1,530'
Salt and shale 1,650'
Shale and lime 1,885'
Lime 2,390'
Lime and shale 2,965'
Lime 3,448' RTD

RECEIVED
STATE CORPORATION COMMISSION
JUL 1 1964
CONSERVATION DIVISION
Wichita, Kansas

NOTES

DST #1 3,185' - 3,215' Tool open 1 hr. Recovered 60' oil specked mud.
IBHP - 705#, IFP - 0#, FFP - 0#, FBHP-610#/20 min.

DST #2 3,215' - 3,280' Tool open 1 hr. Recovered 130' oil specked mud.
IBHP - 740#, IFP - 10#, FFP - 120#, FBHP-520#/ 20 min.