


15-051-22072-00-00

STATE OF KANSAS
STATE CORPORATION COMMISSION

Form CP-4

Give All Information Completely
Make Required Affidavit
Mail or Deliver Report to:
Conservation Division
State Corporation Commission
P. O. Box 17027
Wichita, Kansas 67217
NORTH

WELL PLUGGING RECORD

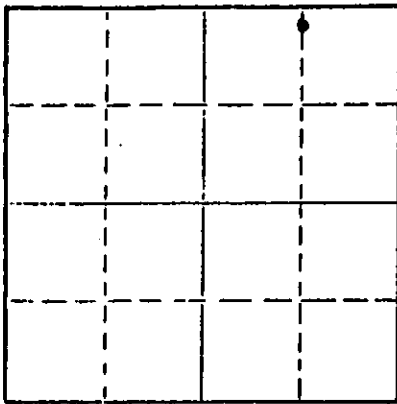

Locate well correctly on above
Section Plat

ELLIS County, Sec. 17 Twp. 14 Rge. 16 (E)XXX(W)
Location as "NE/CNW/SW" or footage from lines C N $\frac{1}{2}$ N $\frac{1}{2}$ NE $\frac{1}{2}$
Lease Owner R P NIXON OPERATIONS
Lease Name ROHLERD Well No. ONE
Office Address 207 W 12TH HAYS KS 67601
Character of Well (completed as Oil, Gas or Dry Hole) DRY HOLE
Date well completed 9-19-1980
Application for plugging filed 9-19-1980
Application for plugging approved 9-19-1980
Plugging commenced 9-19-1980
Plugging completed 9-19-1980
Reason for abandonment of well or producing formation NON-COMMERCIAL

If a producing well is abandoned, date of last production NA 19
Was permission obtained from the Conservation Division or its agents before plugging was commenced? YES

Name of Conservation Agent who supervised plugging of this well MARION SCHMIDT
Producing formation _____ Depth to top _____ Bottom _____ Total Depth of Well 3530 Feet
Show depth and thickness of all water, oil and gas formations.

OIL, GAS OR WATER RECORDS

CASING RECORD

FORMATION	CONTENT	FROM	TO	SIZE	PUT IN	PULLED OUT
SURFACE				8 5/8	182	0

Describe in detail the manner in which the well was plugged, indicating where the mud fluid was placed and the method or methods used in introducing it into the hole. If cement or other plugs were used, state the character of same and depth placed, from _____ feet to _____ feet for each plug set.

70 sx @ 620'
25 sx @ 210' 50/50 pozmix 6% gel
10 sx @ 40'
5 sx in rathole

RECEIVED
STATE CORPORATION COMMISSION

JUL - 2 1981 07-02-81

CONSERVATION DIVISION
Wichita, Kansas

(If additional description is necessary, use BACK of this sheet)
Name of Plugging Contractor JAY-LAN CORPORATION

Address 207 W 12TH HAYS KS 67601

STATE OF KANSAS COUNTY OF ELLIS
DARRYL APEL (employee of owner) or (owner or operator) of the above-described

well, being first duly sworn on oath, says: That I have knowledge of the facts, statements, and matters herein contained and the log of the above-described well as filed and that the same are true and correct. So help me God.

(Signature) *Darryl Apel*
207 W 12TH HAYS KS 67601

(Address)

SUBSCRIBED AND SWORN TO before me this 24 day of JUNE 1981

My commission expires 7-15-84

Maree N Stefan
Maree N Stefan Notary Public.



15-051-22072-00-00

DRILLER'S LOG

COMPANY: R P NIXON OPERATIONS

SEC. 17 T. 14 R. 16W

WELL NAME: ROHLER

LOC. C N½ N½ NE½

RIG NO. 3

COUNTY: ELLIS

TOTAL DEPTH: 3530

ELEV: 1917 GR

COMMENCED: 9-9-80

COMPLETED: 9-19-80

CONTRACTOR: JAY-LAN CORPORATION

CASING RECORD:

SURFACE: 182' 8 5/8"

PRODUCTION: NONE

LOG

(Figures Indicate ~~Bottom~~ of Formations)
TOPS

ANHYDRITE	1038
BASE ANHYDRITE	1074
TOPEKA LIME	2924
HEEBNER SHALE	3146
TORONTO LIME	3166
LANSING	3195
BASE KANSAS CITY	3428
ARBUCKLE DOLOMITE	3443
R T D	3530

RECEIVED
STATE CORPORATION COMMISSION
JUL - 2 1981
CONSERVATION DIVISION
Wichita, Kansas

STATE OF KANSAS)
COUNTY OF ELLIS) SS:

I, DARRYL APEL of JAY-LAN CORPORATION
upon oath state that the above and foregoing is a true and correct
copy of the log of the ROHLER #1 well.

Darryl Apel

Subscribed and sworn to before me this 24 day of JUNE, 1981.

MAREE N. STEFAN
STATE NOTARY PUBLIC
Ellis County, Kansas
My Appl Expires 7-15-84

My appointment expires:
7-15-84

Maree N Stefan
MAREE N STEFAN