

15-051-23429-00-00


STATE OF KANSAS
STATE CORPORATION COMMISSION

WELL PLUGGING RECORD

Give All Information Completely
Make Required Affidavit
Mail or Deliver Report to
Conservation Division
State Corporation Comm.
245 North Water
Wichita, KS 67202

Ellis County, Sec. 15 Twp. 14 Rge. 16 E/W
Location as "NE/CNW 1/4 SW 1/4" or footage from lines
NE/4

Lease Owner Dreiling Resources, Inc.
Lease Name Dortland Well No. 1
Office Address P. O. Box 278, Victoria, KS 67671
Character of Well (Completed as Oil, Gas or Dry Hole)

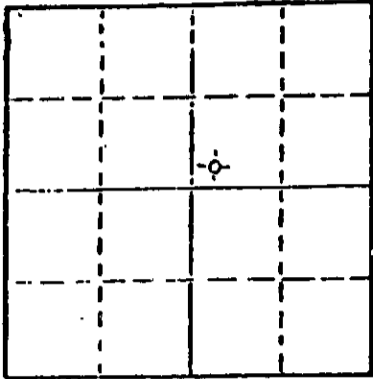

Locate well correctly on above
Section Plot

Dry Hole
Date Well completed 5-4 19 83
Application for plugging filed 5-4 19 83
Application for plugging approved 5-4 19 83
Plugging commenced 5-4 19 83
Plugging completed 5-4 19 83
Reason for abandonment of well or producing formation

If a producing well is abandoned, date of last production 19

Was permission obtained from the Conservation Division or its agents before plugging was commenced? Yes

Name of Conservation Agent who supervised plugging of this well Gilbert Scheck
Producing formation Depth to top Bottom Total Depth of Well 3465'
Show depth and thickness of all water, oil and gas formations.

OIL, GAS OR WATER RECORDS

CASING RECORD

FORMATION	CONTENT	FROM	TO	SIZE	PUT IN	PULLED OUT
				8 5/8"	127'	-0-
					130'	

Describe in detail the manner in which the well was plugged, indicating where the mud fluid was placed and the method or methods used in introducing it into the hold. If cement or other plugs were used, state the character of same and depth placed, from feet to feet for each plug set.


- 1st plug was set at 1000' with 20 sacks cement
- 2nd plug was set at 660' with 80 sacks cement
- 3rd plug was set at 200' with 40 sacks cement
- 4th plug was set at 40' with 10 sacks cement

(If additional description is necessary, use BACK of this sheet)

Name of Plugging Contractor Dreiling Oil, Inc., Box 1000, Victoria, KS 67671

STATE OF KANSAS COUNTY OF ELLIS, ss.
ALBERT J. DREILING (employee of owner) or (owner or operator)
of the above-described well, being first duly sworn on oath, says: That I have knowledge of the facts, statements, and matters herein contained and the log of the above-described well as filed and that the same are true and correct. So help me God.

(Signature) [Signature]
P.O. Box 278 Victoria 67671
(Address)

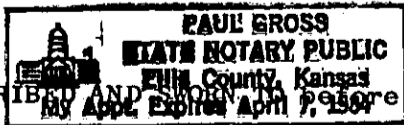

SUBSCRIBED AND SWORN TO before me this 20th day of MAY, 1983

My Appointment commission expires April 7, 1984

[Signature]
Notary Public.

RECEIVED
STATE CORPORATION COMMISSION

MAY 23 1983

CONSERVATION DIVISION
Wichita, Kansas