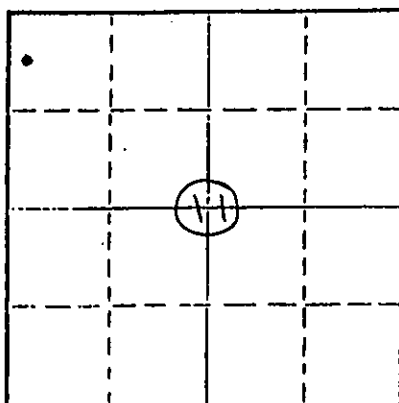


STATE OF KANSAS
STATE CORPORATION COMMISSION

Form CP-4

Give All Information Completely
Make Required Affidavit
Mail or Deliver Report to:
Conservation Division
State Corporation CommissionP. O. Box 17027
Wichita, Kansas 67217
NORTHLocate well correctly on above
Section Plat

WELL PLUGGING RECORD

ELLIS County, Sec. 11 Twp. 14 Rge. 16 (E) (W) X
Location as "NE/CNW/SW" or footage from lines CW/2 NW NW
Lease Owner R P NIXON OPERATIONS
Lease Name ROBEN C Well No. ONE
Office Address 207 W 12TH HAYS KS 67601
Character of Well (completed as Oil, Gas or Dry Hole) DRY HOLE
Date well completed 2-27 1981
Application for plugging filed 2-27 1981
Application for plugging approved 2-27 1981
Plugging commenced 2-27 1981
Plugging completed 2-27 1981
Reason for abandonment of well or producing formation NON-COMMERCIAL
If a producing well is abandoned, date of last production NA 19
Was permission obtained from the Conservation Division or its agents before plugging was commenced? YES

Name of Conservation Agent who supervised plugging of this well MARION SCHMIDT
Producing formation Depth to top Bottom Total Depth of Well 3450 Feet
Show depth and thickness of all water, oil and gas formations.

OIL, GAS OR WATER RECORDS

CASING RECORD

FORMATION	CONTENT	FROM	TO	SIZE	PUT IN	PULLED OUT
SURFACE				8 5/8	200	0

Describe in detail the manner in which the well was plugged, indicating where the mud fluid was placed and the method or methods used in introducing it into the hole. If cement or other plugs were used, state the character of same and depth placed, from feet to feet for each plug set.

65 sx @ 660' 55 sx common
30 sx @ 210' 55 sx poxmix
10 sx @ 40' 7 sx gel
5 sx in rathole

RECEIVED
STATE CORPORATION COMMISSION

JUN - 27 1981 07-02-81

CONSERVATION DIVISION
Wichita, Kansas

(If additional description is necessary, use BACK of this sheet)
Name of Plugging Contractor JAY-LAN CORPORATION
Address 207 W 12TH HAYS KS 67601

STATE OF KANSAS COUNTY OF ELLIS ss.
DARRYL APEL (employee of owner) or (owner or operator) of the above-described well, being first duly sworn on oath, says: That I have knowledge of the facts, statements, and matters herein contained and the log of the above-described well as filed and that the same are true and correct. So help me God.

(Signature)

Darryl Apel

207 W 12TH HAYS KS 67601

(Address)

Subscribed and Sworn to before me this 26 day of JUNE, 1981

My commission expires 7-15-84

MAREE N. STEFAN
STATE NOTARY PUBLIC
Ellis County, Kansas
My App. Expires 7-15-84

Maree N Stefan

Notary Public.

15-051-22289-00-00

DRILLER'S LOG

COMPANY: R P NIXON OPERATIONS

SEC. 11 T. 14 R.16W

WELL NAME: ROBBEN C #1

LOC.C W/2 NW NW

RIG NO. 3

COUNTY: ELLIS

CONTRACTOR: JAY-LAN CORPORATION

TOTAL DEPTH: 3450

ELEV. 1920 GR

COMMENCED: 2-19-81

COMPLETED: 2-27-81

CASING RECORD:

SURFACE: 200 FEET OF 8 5/8" SET AT 200'

PRODUCTION: NONE FEET OF SET AT

LOG

(Figures Indicate Top of Formations)

ANHYDRITE TOP (DRLRS)	1029
ANHYDRITE BASE (DRLRS)	1066
TOPEKA LIME	2912
HEEBNER SHALE	3136
TORONTO LIME	3156
LANSING	3181
BASE OF KANSAS CITY	3418
CONGLOMERATE	3434
R T D	3450

RECEIVED
STATE CORPORATION COMMISSION

JUN - 2 1981

CONSERVATION DIVISION
Wichita, Kansas

STATE OF KANSAS) SS:
COUNTY OF ELLIS)

I, DARRYL APEL of JAY-LAN CORPORATION upon
oath state that the above and forgoing is a true and
correct copy of the log of the ROBBEN C #1
well.

Darryl Apel

Subscribed and sworn to before me this 26 day of JUNE
19 81.

My appt expires 7-15-84

Maree N Stefan
Maree N Stefan

