

15-051-06877-00-00


STATE OF KANSAS
STATE CORPORATION COMMISSION

WELL PLUGGING RECORD

Give All Information Completely
Make Required Affidavit
Mail or Deliver Report to:
Conservation Division
State Corporation Commission
800 Bittling Building
Wichita, Kansas

Ellis County, Sec. 10 Twp. 14 Rge. (E) 16 (W)

NORTH

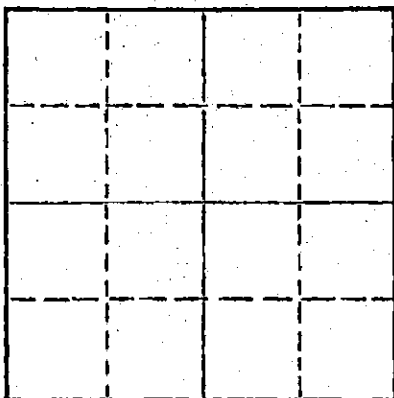

Locate well correctly on above
Section Plat

Location as "NE/CNWxSWx" or footage from lines NW NW SW
Lease Owner Iron Drilling Company
Lease Name Kuhn Well No. 1
Office Address 1206 Philtower Bldg., Tulsa, Okla.
Character of Well (completed as Oil, Gas or Dry Hole) Dry Hole
Date well completed 9/1/55 19
Application for plugging filed 9/1/55 19
Application for plugging approved 9/1/55 19
Plugging commenced 9/1/55 19
Plugging completed 9/1/55 19
Reason for abandonment of well or producing formation Dry Hole

If a producing well is abandoned, date of last production Dry Hole 19
Was permission obtained from the Conservation Division or its agents before plugging was commenced? Yes

Name of Conservation Agent who supervised plugging of this well Eldon Petty
Producing formation None Depth to top _____ Bottom _____ Total Depth of Well 3459 Feet
Show depth and thickness of all water, oil and gas formations.

OIL, GAS OR WATER RECORDS

CASING RECORD

FORMATION	CONTENT	FROM	TO	SIZE	PUT IN	PULLED OUT
Heebner	Water	3111		8-5/8"	257	None
Toronto	"	3131				
Lansing	"	3157				
Arbuckle	"	3137				

Describe in detail the manner in which the well was plugged, indicating where the mud fluid was placed and the method or methods used in introducing it into the hole. If cement or other plugs were used, state the character of same and depth placed, from _____ feet to _____ feet for each plug set.

Hole filled with heavy Mud to 247 feet

Set cement Plug using 20 sacks cement 1/2 sack hulls

Set top cement plug at 40 feet using 10 sacks cement and 1/2 sack hulls

(If additional description is necessary, use BACK of this sheet)

Name of Plugging Contractor Iron Drilling Company
Address 1206 Philtower Bldg., Tulsa, Okla.

STATE OF Oklahoma COUNTY OF Tulsa, ss.
J. L. Stackpole

(employee of owner) or (owner or operator) of the above-described well, being first duly sworn on oath, says: That I have knowledge of the facts, statements, and matters herein contained and the log of the above-described well as filed and that the same are true and correct. So help me God.

(Signature) J. L. Stackpole
Tulsa, Okla.
(Address)

SUBSCRIBED AND SWORN TO before me this 13th day of September, 19 55

B. Michal
Notary Public.

My commission expires Feb. 28, 1956

PLUGGING
FILE SEC 10 T 14 R 166
BOOK PAGE 147 LINE 27

CONSERVATION
Wichita, Kan. 09-17-55

DRILLING RECORD

15-051-06877-00-00

Well No. 1 Kuhn
 NW NW SW Sec 10-14S-16W
 Ellis County, Kansas

Casing Record

258' of 8-5/8" OD Surface Pipe
 cemented with 200 sacks.

Well Commenced 8/21/55
 Drilling Commenced 8/21/55
 Drilling Completed 8/31/55
 Well Completed 9/1/55

No Oil String - Dry Hole

WELL LOG

Surface Soil	0 to 15
Clay & Rock & Gravel	15 to 69
Sand & Shale	69 to 200
Shale	200 to 460
Sand & Shale	460 to 680
Red Bed	680 to 700
Shale & Shells	700 to 1015
Anhydrite	1015 to 1055
Red Bed	1055 to 1150
Shale & Shells	1150 to 1570
Shale	1570 to 1717
Ft. Riley	1717 to 1820
F.R. Lime	1820 to 1970
Lime & Shale	1970 to 3010
Lime	3010 to 3050
Lime & Shale	3050 to 3130
Lime	3130 to 3190
K.C. Lime	3190 to 3230
Lime	3230 to 3276
K.C. Lime	3276 to 3347
Lime	3347 to 3409
Conglomerate	3409 to 3437
Arbuckle	3437 to 3459 TD

PLUGGING
 FILE SEC 10 T 14 R 16 W
 BOOK PAGE 47 LINE 37