

15-051-20461-00-00


STATE OF KANSAS
STATE CORPORATION COMMISSION

Form CP-4

Give All Information Completely
Make Required Affidavit
Mail or Deliver Report to:
Conservation Division
State Corporation Commission
212 No. Market
Wichita, Kansas

WELL PLUGGING RECORD

NORTH

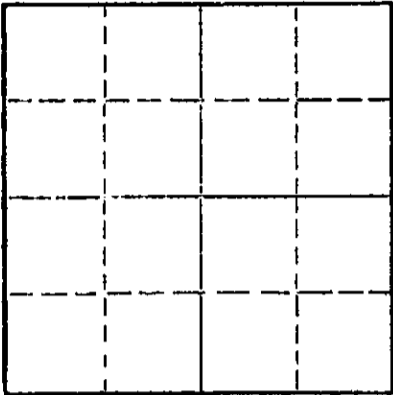

Locate well correctly on above
Section Plat

Ellis County, Sec. 10 Twp 14 Rge 16 (E) W (W)

Location as "NE/CNWKSW" or footage from lines S/2 N/2 NE/4

Lease Owner Frank Polcyn

Lease Name Polcyn Well No. 1

Office Address 226 Fossil, Russell, Kansas

Character of Well (completed as Oil, Gas or Dry Hole) Dry hole

Date well completed July 18, 1969

Application for plugging filed July 16, 1969

Application for plugging approved July 16, 1969

Plugging commenced July 16, 1969

Plugging completed July 16, 1969

Reason for abandonment of well or producing formation Dry hole

If a producing well is abandoned, date of last production 19

Was permission obtained from the Conservation Division or its agents before plugging was commenced? Yes

Name of Conservation Agent who supervised plugging of this well Leo Massey

Producing formation Depth to top Bottom Total Depth of Well 3,460 Feet

Show depth and thickness of all water, oil and gas formations.

OIL, GAS OR WATER RECORDS

CASING RECORD

FORMATION	CONTENT	FROM	TO	SIZE	PUT IN	PULLED OUT
				8 5/8"	256'	Cmtd. w/ 150 sax

Describe in detail the manner in which the well was plugged, indicating where the mud fluid was placed and the method or methods used in introducing it into the hole. If cement or other plugs were used, state the character of same and depth placed, from feet to feet for each plug set.

Fill hole w/ heavy mud
Set bridge plug @ 550'
Pump 120 sax cement on plug to cellar thru 4 1/2" drill pipe

RECEIVED
STATE CORPORATION COMMISSION
JUL 28 1969
CONSERVATION DIVISION
Wichita, Kansas

(If additional description is necessary, use BACK of this sheet)

Name of Plugging Contractor Shields Drilling Co., Inc.
Address Shields Bldg., Russell, Kansas

STATE OF Kansas COUNTY OF Russell
R. J. Shields contractor

well, being first duly sworn on oath, says: That I have knowledge of the facts, statements, and matters herein contained and the log of the above-described well as filed and that the same are true and correct. So help me God.

(Signature) R. J. Shields
Shields Bldg., Russell, Kansas (Address)

SUBSCRIBED AND SWORN TO before me this 25th day of July, 1969

My commission expires May 26, 1971 Notary Public.



Shields


15-051-20461-00-00

Russell, Kansas

WELL LOG

Operator: Frank Polcyn
 Well: Polcyn #1
 Commenced: July 9, 1969
 Completed: July 16, 1969
 Contractor: Shields Drilling Co., Inc.

Well Description: S/2 N/2 NE/4
 Sec. 10-14S-16W
 Ellis County, Kansas

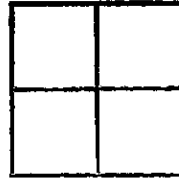

CASING RECORD		
Size	Run	Pulled
8 5/8"	256'	Cmtd. w/ 150 sax

Elevation: 1,929' RB
 Treatment:
 Production: D & A
 Tops: Heebner 3,128'
 Toronto 3,147'
 Lansing-KC 3,174'
 Arbuckle 3,424'

..... Figures Indicate Bottom of Formations

Shale	260'
Shale & sand	660'
Redbed	1,019'
Anhydrite	1,057'
Shale	1,170'
Shale & shells	1,670'
Lime & shale	2,965'
Lime	3,460' RTD

NOTES

- DST #1 3,177' - 3,225' Tool open 90 min. w/ very weak blow increasing to fair. Recovered 200' mud. IBHP-818#, IFP-50#, FFP-150#, FBHP-725#/ 30 min.
- DST #2 3,234' - 3,255' Tool open 1hr. w/ fair blow thruout. Recovered 350' muddy water. IBHP-815#, IFP-48#, FFP-140#, FBHP-693#/ 30 min.
- DST #3 3,408' - 3,435' Tool open w/ weak blow dying in 5 min. Recovered 10' mud. IBHP-not taken, IFP-0#, FFP-0#, FBHP-370#/ 30 min.

RECEIVED
 STATE CORPORATION COMMISSION
 JUL 28 1969
 CONSERVATION DIVISION
 Wichita, Kansas