


STATE CORPORATION COMMISSION

15-051-01495-00-00
WELL PLUGGING RECORD

Give Information Completely
Make Required Affidavit
Mail or Deliver Report to:
Conservation Division
State Corporation Commission
211 No. Broadway
Wichita, Kansas

NORTH

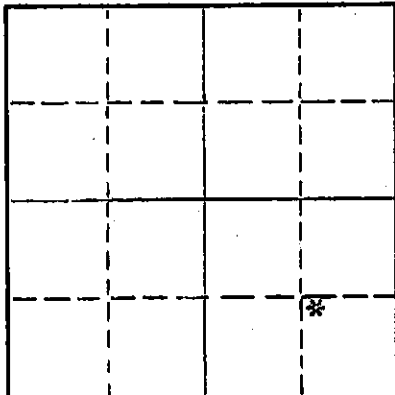

Locate well correctly on above
Section Plat

Ellis County, Sec. 6 Twp. 14 Rge. 16 (E) (W)
Location as "NE/CNW/SE" or footage from lines 31 32 NE
Lease Owner V. Francis Weigel
Lease Name Kipes Well No. 1
Office Address Gorham, Kansas
Character of Well (completed as Oil, Gas or Dry Hole) Dry Hole
Date well completed March 8, 1962 19
Application for plugging filed March 8, 1962 19
Application for plugging approved March 8, 1962 19
Plugging commenced March 8, 1962 19
Plugging completed March 8, 1962 19
Reason for abandonment of well or producing formation -0-

If a producing well is abandoned, date of last production -0- 19
Was permission obtained from the Conservation Division or its agents before plugging was commenced? Yes

Name of Conservation Agent who supervised plugging of this well Eldon Petty
Producing formation -0- Depth to top -0- Bottom -0- Total Depth of Well 3521' Feet
Show depth and thickness of all water, oil and gas formations.

OIL, GAS OR WATER RECORDS

CASING RECORD

FORMATION	CONTENT	FROM	TO	SIZE	PUT IN	PULLED OUT
Surface Pipe				8 5/8"	180'	-0-

Describe in detail the manner in which the well was plugged, indicating where the mud fluid was placed and the method or methods used in introducing it into the hole. If cement or other plugs were used, state the character of same and depth placed, from _____ feet to _____ feet for each plug set.

Rotary mud was used to fill hole to a depth of 180' where 1st plug was set using 20 sacks cement, 2nd plug was set at 130' using 20 sacks cement, 3rd plug was set at 10' using 10 sacks cement and filling to top of hole.

RECEIVED
STATE CORPORATION COMMISSION
MAR 15 1962
CONSERVATION DIVISION
Wichita, Kansas
03-15-62

(If additional description is necessary, use BACK of this sheet)

Name of Plugging Contractor L. J. DREILING & SONS, INC.
Address VICTORIA, KANSAS

STATE OF KANSAS COUNTY OF ELLIS, ss.
I, Leo E. Dreiling a contractor (employee of owner) (owner) (operator) of the above-described well, being first duly sworn on oath, says: That I have knowledge of the facts, statements, and matters herein contained and the log of the above-described well as filed and that the same are true and correct. So help me God.

(Signature) Leo E. Dreiling
Leo E. Dreiling
Victoria, Kansas (Address)

SUBSCRIBED AND SWORN to before me this 12th day of March, 1962

Ronald Zimmerman
Notary Public.

My commission expires August 14, 1965

15-051-01495-00-00

L. J. DREILING and SONS, Inc.

VICTORIA, KANSAS

WELL LOG

Company Francis Weigel
 Farm Gorham, Kansas Kippes No. 1
 Total Depth 3521'
 Comm. March 1, 1962 Comp. March 8, 1962
 Contractor L. J. DREILING & SONS, INC.
 Casing Record: 8 5/8" - - - - 180' Cement Record: 100 sacks cement
 Sec. 6 Twp. 14 Rng. 16
 Location SE SE NE
 County Ellis County, Kansas
 Elevation: D. F. 1970'
 G. R.
 Production: D. & A.

Figures Indicate Bottom of Formations

0 - 65	Surface Clay
65 - 180	Clay & Shale
180 - 390	Shale
390 - 700	Sand & Shale
700 - 810	Shale
810 - 1080	Red Rock & Shale
1080 - 1127	Anhydrite
1127 - 1580	Shale & Shells
1580 - 1960	Shale & Lime
1960 - 2185	Lime & Shale
2185 - 2235	Lime
2235 - 2338	Shale & Broken Lime
2338 - 2560	Lime & Shale
2560 - 2763	Shale & Lime
2763 - 2910	Shale & Broken Lime
2910 - 3090	Lime & Shale
3090 - 3180	Lime
3180 - 3192	Lime
3192 - 3196	Heebner Shale
3196 - 3275	Lime
3275 - 3392	Lime
3392 - 3521	Lime
3521	TD

STATE OF KANSAS)
) ss.
 COUNTY OF ELLIS)

RECEIVED
 STATE CORPORATION COMMISSION
 MAR 15 1962
 CONSERVATION DIVISION
 Wichita, Kansas

I, Leo F. Dreiling, of the L. J. Dreiling & Sons, Inc., upon oath states that the above and foregoing is a true and correct copy of the log from the Daily Drilling Report on your Kippes No.1

Leo F. Dreiling
 LEO F. DREILING

Subscribed and sworn to before me this 12th day of March, 1962

Robert Zimmerman
 NOTARY PUBLIC

My Commission Expires: August 14, 1965