


All Information Completely
Required Affidavit
or Deliver Report to:
Conservation Division
State Corporation Commission
12 No. Market
Topeka, Kansas

WELL PLUGGING RECORD

15-051-23520-00-00
Form CP-4

NORTH

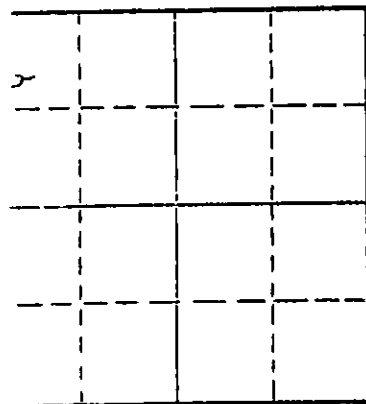

Locate well correctly on above
Section Plot

Ellis County, Sec. 6 Twp. 14 Rge. 16 (E) x (W)

Location as "NE/CNW/SW" or footage from lines SW NW NW

Lease Owner Weibert Enterprises

Lease Name Kippes-Weibert Well No. 1

Office Address 652 Hays, Ks. 67601

Character of Well (completed as Oil, Gas or Dry Hole) Dry Hole

Date well completed 7-14 1983

Application for plugging filed 7-14 1983

Application for plugging approved 7-14 1983

Plugging commenced 7-14 1983

Plugging completed 7-14 1983

Reason for abandonment of well or producing formation

Dry Hole

If a producing well is abandoned, date of last production 19

Was permission obtained from the Conservation Division or its agents before plugging was commenced? Yes

Name of Conservation Agent who supervised plugging of this well Gilbert Scheck

Producing formation Depth to top Bottom Total Depth of Well 3523' Feet

Give depth and thickness of all water, oil and gas formations.

OIL, GAS OR WATER RECORDS

CASING RECORD

FORMATION	CONTENT	FROM	TO	SIZE	PUT IN	PULLED OUT
Surface		0	208'	8 5/8"	208'	0

Describe in detail the manner in which the well was plugged, indicating where the mud fluid was placed and the method or methods used in introducing it into the hole. If cement or other plugs were used, state the character of same and depth placed, from feet to feet for each plug set.

1st. Plug set at 3500' with 20 sacks common cement 50-50 Poz 3% Cal Cl 4% Gel

2nd. Plug set at 1100' with 20 sacks common cement 50-50 Poz 3% Cal Cl 4% Gel

3rd. Plug set at 600' with 80 sacks common cement 50-50 Poz 3% Cal Cl 4% Gel

4th Plug set at 250' with 40 sacks common cement 50-50 Poz 3% Cal Cl 4% Gel

5th Plug set at 40' with solid bridge and 10 sacks common cement 50-50 Poz 3% Cal Cl 4% Gel

10 sacks in rathole

(If additional description is necessary, use BACK of this sheet)

Name of Plugging Contractor Sun Oilwell Cementing

Address Hays, Ks. 67601

STATE OF Kansas COUNTY OF Graham ss.

I, Jerry M. Helberg (employee of owner) or (owner or operator) of the above-described well, being first duly sworn on oath, says: That I have knowledge of the facts, statements, and matters herein contained and the log of the above-described well as filed and that the same are true and correct. So help me God.

(Signature)

Box 32

Morland, Ks. 67650

(Address)

SUBSCRIBED AND SWORN to before me this 27 day of July, 1983

Commission expires 12-4-83



Notary Public.

STATE OF KANSAS CONSERVATION DIVISION

DEC 5 1983

12-0583