


STATE OF KANSAS
STATE CORPORATION COMMISSION

WELL PLUGGING RECORD

Give All Information Completely
Make Required Affidavit
Mail or Deliver Report to
Conservation Division
State Corporation Comm.
245 North Water
Wichita, KS 67202

Ellis County, Sec. 6 Twp. 14S Rge. 16W E/W
Location as "NE/CNW $\frac{1}{2}$ /SW $\frac{1}{2}$ " or footage from lines
E $\frac{1}{2}$ SE SE

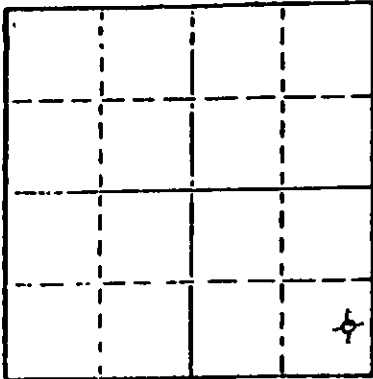

Locate well correctly on above
Section Plot

Lease Owner Knight Oil
Lease Name Dreiling Well No. 1
Office Address Victoria, Kansas 67671
Character of Well (Completed as Oil, Gas or Dry Hole)

Dry Hole
Date Well completed 9-26 1981
Application for plugging filed 9-26 1981
Application for plugging approved 9-26 1981
Plugging commenced 9-26 1981
Plugging completed 9-26 1981

Reason for abandonment of well or producing formation
Dry Hole
If a producing well is abandoned, date of last production 19

Was permission obtained from the Conservation Division or
its agents before plugging was commenced? Yes

Name of Conservation Agent who supervised plugging of this well Gib Scheck
Producing formation _____ Depth to top _____ Bottom _____ Total Depth of Well 3500'
Show depth and thickness of all water, oil and gas formations.

OIL, GAS OR WATER RECORDS

CASING RECORD

FORMATION	CONTENT	FROM	TO	SIZE	PUT IN	PULLED OUT
Surface		0	204'	8 5/8"	204	0

Describe in detail the manner in which the well was plugged, indicating where the mud fluid was placed and the method or methods used in introducing it into the hold. If cement or other plugs were used, state the character of same and depth placed, from _____ feet to _____ feet for each plug set.

1st Plug set at 780' with 70 sacks common cement 3% Cal Cl 4% Gel 50-50poz
2nd Plug set at 210' with 40 sacks common cement 3% Cal Cl 4% Gel 50-50 poz
3rd. Plug set at 40' with 10 sacks common cement 3% Cal Cl 4% Gel 50-50poz
5 sacks rathole

Heavy drilling mud between each plug
(If additional description is necessary, use BACK of this sheet)


Name of Plugging Contractor Allied Cementing

STATE OF Kansas COUNTY OF Graham, ss.
Jerry M. Helberg (employee of owner) or (owner or operator)
of the above-described well, being first duly sworn on oath, says: That I have knowledge of the facts, statements, and matters herein contained and the log of the above-described well as filed and that the same are true and correct. So help me God.

(Signature) Jerry M. Helberg
Box 32 Morland, Kansas 67650
(Address)

SUBSCRIBED AND SWORN TO before me this 8 day of Oct, 1981
Faye E. Murrin
Notary Public.

My commission expires _____

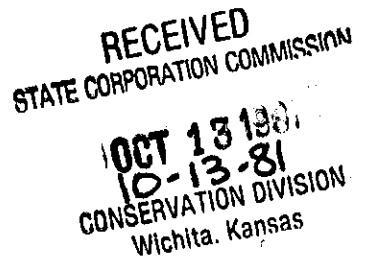

DRILLERS LOG

DREILING #1

CASING RECORD:

8 5/8" set at 204'

TOTAL DEPTH:

3500'

DESCRIPTION:

E 1/2 SE SE

Sec. 6, Twp.14, Rge.16

OPERATOR: Knight Oil

CONTRACTOR: Helberg Oil Company

COMMENCED: September 18, 1981

COMPLETED: September 26, 1981

FORMATION	FROM	TO	REMARKS
Sand	0	229	
Sand	229	324	
Sand & Shale	324	916	
Shale	916	1080	
Anhydrite	1080	1121	
Shale	1121	1141	
Shale	1141	1761	
Shale	1761	1946	
Shale	1946	2093	
Shale	2093	2175	
Lime & Shale	2175	2272	
Lime & Shale	2272	2430	
Lime & Shale	2430	2544	
Lime & Shale	2544	2623	
Lime & Shale	2623	2751	
Lime & Shale	2751	2872	
Lime & Shale	2872	2980	
Lime & Shale	2980	3075	
Lime & Shale	3075	3125	
Lime & Shale	3125	3205	
Lime	3205	3266	
Lime	3266	3320	
Lime	3320	3387	
Lime	3387	3452	
Lime	3452	3500	
T.D.	3500		

RECEIVED
STATE CORPORATION COMMISSION
OCT 13 1981
D & A
CONSERVATION DIVISION
Wichita Kansas

I certify that the above is a true and correct copy of the log to the best of my knowledge.

Helberg Oil Company

Jermy M. Helberg
Jermy M. Helberg

Subscribed and sworn to before me this 8 day of Oct, 1981.

Wayne E. Minium
Notary Public

My commission expires _____

