

Give All Information Completely  
Make Required Affidavit  
Mail or Deliver Report to:  
Conservation Division  
State Corporation Commission  
211 No. Broadway  
Wichita, Kansas

WELL PLUGGING RECORD

Ellis County, Sec 6 Twp 14 Rge 16 (E) (W) X  
Location as "NE/CNW/SW" or footage from lines SE NW SE

Lease Owner V. Francis Weigel  
Lease Name Dreiling Well No. 1

Office Address Gorham, Kansas

Character of Well (completed as Oil, Gas or Dry Hole) D. & A.

Date well completed 8/25/63 19

Application for plugging filed 8/25/63 19

Application for plugging approved 8/25/63 19


Plugging commenced 8/25/63 19

Plugging completed 8/25/63 19

Reason for abandonment of well or producing formation -0-

If a producing well is abandoned, date of last production -0- 19

Was permission obtained from the Conservation Division or its agents before plugging was commenced? Yes

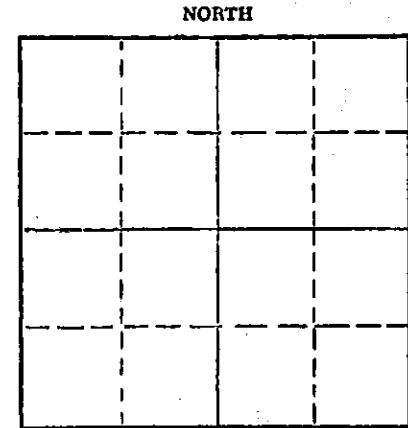

Locate well correctly on above Section Plat

Name of Conservation Agent who supervised plugging of this well Eldon Petty

Producing formation -0- Depth to top -0- Bottom -0- Total Depth of Well 3505' Feet

Show depth and thickness of all water, oil and gas formations.

OIL, GAS OR WATER RECORDS

CASING RECORD

FORMATION	CONTENT	FROM	TO	SIZE	PUT IN	PULLED OUT
Surface Pipe				8 5/8"	169'	-0-

Describe in detail the manner in which the well was plugged, indicating where the mud fluid was placed and the method or methods used in introducing it into the hole. If cement or other plugs were used, state the character of same and depth placed, from \_\_\_\_\_ feet to \_\_\_\_\_ feet for each plug set.

Rotary mud was used in filling hole to a depth of 480' where 1st plug was set using 20 sacks cement. 2nd plug was set at 170' using 20 sacks cement, 3rd plug was set at 40' using 10 sacks and filling hole to surface.

STATE CORPORATION COMMISSION  
SEP 10 1963  
09-10-63  
CONSERVATION DIVISION  
Wichita, Kansas

(If additional description is necessary, use BACK of this sheet)  
Name of Plugging Contractor L. J. Dreiling & Sons, Inc.  
Address Victoria, Kansas

STATE OF Kansas COUNTY OF Ellis ss.  
I, Leo F. Dreiling a contractor

being first duly sworn on oath, says: That I have knowledge of the facts, statements, and matters herein contained and the log of the above-described well as filed and that the same are true and correct. So help me God.

(Signature) Leo F. Dreiling  
Leo F. Dreiling

(Address)

SUBSCRIBED AND SWORN to before me this 5th day of September, 1963

Notary Public

My commission expires August 11, 1965

WELL LOG

Company V. Francis Weigel Operations  
Gorham, Kansas  
Farm Drilling No. 1

Sec. 6 Twp. 14 Rng. 16W

Location SE/NW/SE

Total Depth 3505'

County Ellis County, Kansas

Comm. 8/19/63

Comp. 8/24/63

Elevation: D. F. \_\_\_\_\_

Contractor L. J. DREILING & SONS, INC.  
VICTORIA, KANSAS

G. R. \_\_\_\_\_

Casing Record

Cement Record

Production:

8 5/8" - - - 169'

\_\_\_\_\_ sacks cement

D. & A.

Figures Indicate Bottom of Formations

0 - 50	Surface Clay
50 - 169	Surface Clay & Shale
169 - 575	Shale & Shells
575 - 740	Sand
740 - 889	Shale
889 - 1090	Shale
1090 - 1130	Anhydrite
1130 - 1600	Shale
1600 - 2005	Shale & Lime
2005 - 2228	Shale & Lime
2228 - 2410	Lime & Shale
2410 - 2617	Shale & Lime
2617 - 2845	Shale & Lime
2845 - 3052	Lime & Shale
3052 - 3135	Lime
3135 - 3265	Lime
3265 - 3320	Lime
3320 - 3388	Lime
3388 - 3470	Lime
3470 - 3500	Lime
3500 - 3505	Lime
3505	TD

RECEIVED  
STATE CORPORATION COMMISSION  
SEP 10 1963  
CONSERVATION DIVISION  
Wichita, Kansas

STATE OF KANSAS )  
                          ) ss.  
COUNTY OF ELLIS )

I, Leo F. Dreiling, of the L. J. Dreiling & Sons, Inc.,  
upon oath states that the above and foregoing is a true and correct  
copy from the Daily Drilling Report from your Drilling No. 1.

Leo F. Dreiling  
LEO F. DREILING

Subscribed and sworn to before me this 5th day of September, 1963.

Ronald Zimmerman  
NOTARY PUBLIC

My Commission Expires: August 14, 1965