

STATE OF KANSAS
STATE CORPORATION COMMISSION

WELL PLUGGING RECORD

Give All Information Completely
Make Required Affidavit
Mail or Deliver Report to
Conservation Division
State Corporation Comm.
245 North Water
Wichita, KS 67202

Ellis County, Sec. 29 Twp. 14 Rge. 18 SW
Location as "NE/CNW $\frac{1}{4}$ SW $\frac{1}{4}$ " or footage from lines
990'/SL 900'/WL SW4

Lease Owner Drilling Ltd. of Colorado
Lease Name Irvin Well No. 2

Office Address 410 - 17th St., Suite 1140, Denver, Colo. 80202

Character of Well (Completed as Oil, Gas or Dry Hole)
Dry Hole

Date Well completed October 21 1982

Application for plugging filed October 28 1982

Application for plugging approved October 21 1982

Plugging commenced 2:45 P.M. October 21 1982

Plugging completed 10:30 P.M. October 21 1982


Reason for abandonment of well or producing formation
Non-productive

If a producing well is abandoned, date of last production
None 1982

Was permission obtained from the Conservation Division or
its agents before plugging was commenced? Yes

Name of Conservation Agent who supervised plugging of this well Paul Barthazor
Producing formation _____ Depth to top _____ Bottom _____ Total Depth of Well 3723'

Show depth and thickness of all water, oil and gas formations.

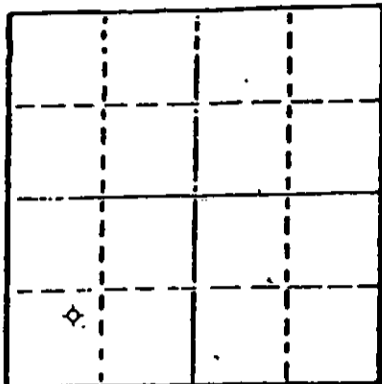

Locate well correctly on above Section Map

OIL, GAS OR WATER RECORDS

CASING RECORD

FORMATION	CONTENT	FROM	TO	SIZE	PUT IN	PULLED OUT
				8-5/8"	210	None

Describe in detail the manner in which the well was plugged, indicating where the mud fluid was placed and the method or methods used in introducing it into the hold. If cement or other plugs were used, state the character of same and depth placed, from _____ feet to _____ feet for each plug set. Hole full of heavy mud. Cemented plugs with 190 sacks 50/50 pozmix with 6% gel, 3% cc. Pumped cement through drillpipe as follows:

- 1st plug at 3650' with 20 sacks
- 2nd plug at 1280' with 20 sacks
- 3rd plug at 660' with 80 sacks
- 4th plug at 240' with 40 sacks
- 5th wood and rubber 8-5/8' plug at 40' with 10 sacks
- Mousehole 10 sacks
- Rathole 10 sacks

(If additional description is necessary, use BACK of this sheet)

Name of Plugging Contractor Halliburton

STATE OF Colorado COUNTY OF Denver, ss.
Leslie Olson (employee of owner) or ~~(owner)~~

of the above-described well, being first duly sworn on oath, says: That I have knowledge of the facts, statements, and matters herein contained and the log of the above-described well as filed and that the same are true and correct. So help me God.

(Signature) Leslie Olson
410 - 17th St., Suite 1140, Denver, Colo. 80202
(Address)

SUBSCRIBED AND SWORN TO before me this 28th day of October, 1982

Sorraine C. Murphy
Notary Public.

My commission expires 9-2-83

RECEIVED
STATE CORPORATION COMMISSION

NOV 1 1982

CONSERVATION DIVISION
Wichita, Kansas