


STATE OF KANSAS
STATE CORPORATION COMMISSION

Form CP-4

Give All Information Completely
Make Required Affidavit
Mail or Deliver Report to:
Conservation Division
State Corporation Commission
211 No. Broadway
Wichita, Kansas

WELL PLUGGING RECORD

NORTH

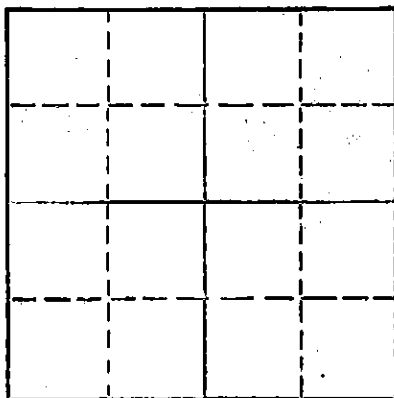

Locate well correctly on above
Section Plat

Ellis County. Sec. 29 Twp. 14S Rge. 18W (E) (W)
Location as "NE/CNW/SW" or footage from lines SW SE NE
Lease Owner Hudson Petroleum etal
Lease Name Menehan Well No. 1
Office Address Box 333, Kansas City, Kansas
Character of Well (completed as Oil, Gas or Dry Hole) Dry hole
Date well completed December 1 1964
Application for plugging filed 19
Application for plugging approved 19
Plugging commenced December 1 1964
Plugging completed December 1 1964
Reason for abandonment of well or producing formation Dry hole

If a producing well is abandoned, date of last production _____ 19____
Was permission obtained from the Conservation Division or its agents before plugging was commenced? Yes

Name of Conservation Agent who supervised plugging of this well Eldon Petty
Producing formation _____ Depth to top _____ Bottom _____ Total Depth of Well 3725 Feet
Show depth and thickness of all water, oil and gas formations.

OIL, GAS OR WATER RECORDS

CASING RECORD

FORMATION	CONTENT	FROM	TO	SIZE	PUT IN	PULLED OUT

Describe in detail the manner in which the well was plugged, indicating where the mud fluid was placed and the method or methods used in introducing it into the hole. If cement or other plugs were used, state the character of same and depth placed, from _____ feet to _____ feet for each plug set.
Bottom plug at 540' with 20 sacks of cement.
Middle plug at 230' with 20 sacks of cement. Top plug at 40' with 1/2 sack hulls and 10 sacks of cement.

RECEIVED
STATE CORPORATION COMMISSION
FEB 9 1965
02-09-65
CONSERVATION DIVISION
Wichita, Kansas

(If additional description is necessary, use BACK of this sheet)
Name of Plugging Contractor Globe Oilwell Cementing, Inc.
Address Great Bend, Kansas

STATE OF Kansas COUNTY OF Sedgwick, ss.
F. S. Woodside, Jr. (employee of owner) or (owner or operator) of the above-described well, being first duly sworn on oath, says: That I have knowledge of the facts, statements, and matters herein contained and the log of the above-described well as filed and that the same are true and correct. So help me God.

(Signature) F. S. Woodside, Jr.
427 Union Center, Wichita, Kansas
(Address)

SUBSCRIBED AND SWORN to before me this 4th day of February, 19 65

My commission expires December 3, 1968
Boeth J. Johnson Notary Public.

ROTARY DRILLING LOG

Operator: Hudson Petroleum Co.
No. 1 Menehan
SW SE NE Sec. 29-14S-18W

Contractor: Omega Drilling, Inc.
Commenced: 11-21-64
Completed: 12- 1-64

Remarks: Set 240' 8 5/8" surface casing with 150 sacks cement.

Formations:

Surface Soil	38'
Lime & Shale	240'
Red Bed & Shale	620'
Dakota Sand	960'
Shale	1310'
Anhydrite	1328'
Shale & Shells	1730'
Shale & Lime	2284'
Lime & Shale	2496'
Shale	2687'
Shale & Shells	2890'
Shale & Lime	3080'
Lime & Shale	3330'
Shale & Lime	3416'
Lime	3474'
Shale & Lime	3508'
Lime	3550'
Shale & Lime	3570'
Lime	3725'

Rotary Total Depth (D&A) 3725'

RECEIVED
STATE CORPORATION COMMISSION
JAN 26 1965
CONSERVATION DIVISION
Wichita, Kansas

We certify the above log is true and correct to the best of our knowledge and belief.

Omega Drilling, Inc.

S. Woodside, Jr.

S. Woodside, Jr.
Executive Vice-President

Subscribed and sworn to before me, a Notary Public in and for the State of Kansas, County of Sedgwick, this 7th day of December, 1964.

My Commission Expires:

SWIFTY PECK, Notary Public
Commission Expires Jan. 8, 1963

[Signature]
Notary Public