

15-051-00811-00-00

STATE OF KANSAS
STATE CORPORATION COMMISSION

WELL PLUGGING RECORD


Give All Information Completely
Make Required Affidavit
Mail or Deliver Report to:
Conservation Division
State Corporation Commission
211 No. Broadway
Wichita, Kansas

Ellis

County. Sec. 27 Twp. 14S Rge. 18 (X) (W)

Location as "NE/CNWxSWx" or footage from lines NE NE NE
Lease Owner Osage Oil & Gas Co.
Lease Name Leiker (Skidded rig 50' W of #1) Well No. #1
Office Address 531 Petroleum Building, Wichita, Kansas
Character of Well (completed as Oil, Gas or Dry Hole) Dry
Date well completed 7/20/56 19
Application for plugging filed 7/19/56 19
Application for plugging approved 7/19/56 19
Plugging commenced 7/20/56 19
Plugging completed 7/20/56 19
Reason for abandonment of well or producing formation Dry hole

NORTH

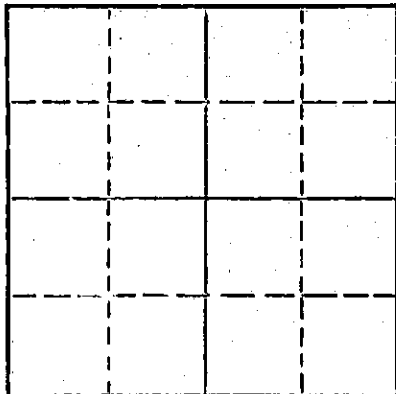

Locate well correctly on above
Section Plat

If a producing well is abandoned, date of last production _____ 19____
Was permission obtained from the Conservation Division or its agents before plugging was commenced? Yes

Name of Conservation Agent who supervised plugging of this well Eldon Petty
Producing formation _____ Depth to top _____ Bottom _____ Total Depth of Well 3690' Feet
Show depth and thickness of all water, oil and gas formations.

OIL, GAS OR WATER RECORDS

CASING RECORD

FORMATION	CONTENT	FROM	TO	SIZE	PUT IN	PULLED OUT
				8 5/8"	1218	None

Describe in detail the manner in which the well was plugged, indicating where the mud fluid was placed and the method or methods used in introducing it into the hole. If cement or other plugs were used, state the character of same and depth placed, from _____ feet to _____ feet for each plug set.

PLUGGING REPORT

Filled hole from 3690' to 0' with heavy mud - wood plug. Pumped 80 sacks of cement in through swedge by Sun Cementing Company, Job completed 1:45 AM - 7/20/56

(If additional description is necessary, use BACK of this sheet)

Name of Plugging Contractor Sierra Petroleum Co., Inc.
Address 420 West Douglas, Wichita, Kansas

STATE OF Kansas, COUNTY OF Russell, ss.
C. T. Honaker (employee of owner) or (owner or operator) of the above-described well, being first duly sworn on oath, says: That I have knowledge of the facts, statements, and matters herein contained and the log of the above-described well as filed and that the same are true and correct. So help me God.

(Signature) C. T. Honaker
Great Bend, Kansas
(Address)

SUBSCRIBED AND SWORN TO before me this 23rd day of July, 1956

My commission expires 10-17-59

Leroy Ditz
Notary Public.

PLUGGING
FILE SEC 27 T 14 R 18W
BOOK PAGE 82 LINE 29

07-27-56
DIVISION

OSAGE OIL & GAS COMPANY
Leiker #1

NE NE NE 27-14S-18W
Ellis County, Kansas

Total Depth: 3690'

Elev: 2008 KB

Comm: 7/5/56
Comp: 7/20/56

Casing	Cement
8 5/8 @ 256' (First Hole)	125 sacks Bulk
8 5/8 @ 1218' (Second Hole)	500 sacks Bulk

FORMATION	DEPTH
Clay	28
Sand Rock	35
Shale	85
Sand & shale	110
Shale & shells	555
Shale & pyrite	592
Shale	650
Sand	775
Red Bed	1216
Anhydrite	1243

Skidded Rig over and started new hole. Dakota water flow.

Shale & shells	70
Sandy shale & shells	555
Shale & pyrite	560
Shale	645
Sand	815
Red Bed & shale	1208
Anhydrite	1245
Red Bed	1450
Shale & salt	1700
Sandy lime & shale	2130
Lime & shale	2525
Shale & shells	2705
Lime & shale	2940
Shale	3025
Shale & lime	3433
Lime	3555
Lime & shale	3585
Conglomerate	3654
Lime	3661
Arbuckle	3690

Tops:	Anhydrite	1208
	Topeka	3001
	Hebner	3250
	Tronto	3270
	Lansing/KC	3296
	Conglomerate	3583
	Arbuckle	3654

STATE OF KANSAS)
) ss:
COUNTY OF RUSSELL)

NOTARY PUBLIC
 J. D. ...
 JUL 27 1956
 OSAGE OIL & GAS COMPANY
 2008 KB
 Ells County, Kansas

I hereby certify that the above information is true and correct to the best of my knowledge.

C. P. Henaker

Subscribed and sworn to before me this 23rd day of July, 1956

Leroy Ditz
Notary Public

My commission expires: 10-17-59

PLUGGING			
FILE	SEC	T	R
	27	14	18W
BOOK	PAGE	LINE	
	79	12	