


WELL PLUGGING RECORD

Give All Information Completely  
Make Required Affidavit  
Mail or Deliver Report to:  
Conservation Division  
State Corporation Commission  
800 Bitting Building  
Wichita, Kansas

NORTH

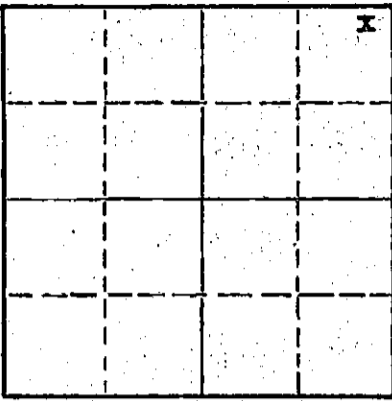

Locate well correctly on above  
Section Plat.

Ellis County, Sec. 24 Twp. 14 Rge. 18 (E) W (W)  
Location as "NE/CNW/SW" or footage from lines NE NE NE  
Lease Owner Transit Corporation & Altman Petroleum Company  
Lease Name Jacobs Bruell Well No. #1  
Office Address 1516 Liberty Bank Bldg., Okla. City, Okla.  
Character of Well (completed as Oil, Gas or Dry Hole) Dry hole  
Date well completed 5-6 1955  
Application for plugging filed 5-6 1955  
Application for plugging approved 5-6 1955  
Plugging commenced 5-6 1955  
Plugging completed 5-6 1955  
Reason for abandonment of well or producing formation \_\_\_\_\_

If a producing well is abandoned, date of last production \_\_\_\_\_ 19\_\_\_\_  
Was permission obtained from the Conservation Division or its agents before plugging was commenced? Yes

Name of Conservation Agent who supervised plugging of this well: Eldon Petty, Hays, Kansas.  
Producing formation \_\_\_\_\_ Depth to top \_\_\_\_\_ Bottom \_\_\_\_\_ Total Depth of Well 3630 Feet  
Show depth and thickness of all water, oil and gas formations.

OIL, GAS OR WATER RECORDS

CASING RECORD

FORMATION	CONTENT	FROM	TO	SIZE	PUT IN	PULLED OUT
				8-5/8"	1,196.65'	None

Describe in detail the manner in which the well was plugged, indicating where the mud fluid was placed and the method or methods used in introducing it into the hole. If cement or other plugs were used, state the character of same and depth placed, from \_\_\_\_\_ feet to \_\_\_\_\_ feet for each plug set.

Filled hole with heavy drilling mud to 250', set plug, squeezed 80 sacks cement through swage nipple. Filled hole to bottom of cellar.

(If additional description is necessary, use BACK of this sheet)

05-12-55

Name of Plugging Contractor Transit Corporation  
Address 1516 Liberty Bank Bldg., Oklahoma City, Okla.

STATE OF Oklahoma, COUNTY OF Oklahoma, ss.  
C. W. Dodson (employee of owner) or (owner or operator) of the above-described well, being first duly sworn on oath, says: That I have knowledge of the facts, statements, and matters herein contained and the log of the above-described well as filed and that the same are true and correct. So help me God.

(Signature) C. W. Dodson  
Oklahoma City, Oklahoma.  
(Address)

SUBSCRIBED AND SWORN to before me this 10th day of May, 1955

My commission expires Jan. 20, 1959

James A. Brady  
Notary Public.

**PLUGGING**  
FILE SEC 24 T 14 R 18W  
BOOK PAGE 117 LINE 24

TRANSIT CORPORATION - ALTMAN PETROLEUM CO.

Jacobs Bruell #1  
NE NE NE Sec. 24-14S-18W, Ellis Co., Kans.

Elevation: 1983 D. F.  
COMMENCED: 4-23-55  
COMPLETED: 5-6-55

<u>FORMATION</u>	<u>TO</u>	<u>FROM</u>	
Clay & Shells	0	197	
Clay & Shale	197	322	
Shale & Shells	322	630	
Sand	630	830	
Shale & Shells	830	1115	
Redbed	1115	1184	
Anhydrite	1184	1195	- 8-5/8" Csg. @ 1189'. Cemented w/
Shale & Shells	1195	1870	550 sacks cement
Lime & Shale	1870	3163	
Lime	3163	3219	
Shale	3219	3234	
Heebner	3234	3238	Top Anhydrite 1184
Lime	3238	3315	Top Heebner 3234
Lime & Shale	3315	3360	Top Cherty Conglomerate 3529
Lime	3360	3529	Rotary Total Depth 3630
Conglomerate	3529	3630	
Total Depth		3630	

FORMATION TOPS

I hereby certify the foregoing to be a true and accurate Driller's log of the formations encountered in the above well.

TRANSIT CORPORATION

BY C. W. Dodson  
(C. W. Dodson)

Subscribed and sworn to before me this 10th day of May, 1955.

Jane A. Brady  
Notary Public

My commission expires Jan. 20, 1959.

RECEIVED  
STATE COMMISSION  
MAY 11 1955  
PLUGGING  
FILE SEC 24 T 14 S 18 W  
BOOK PAGE 117 LINE 24