15-051-22763-00-00

Form CP-4
Rev. 12-15-80

STATE OF KANSAS
STATE CORPORATION COMMISSION
200 Colorado Derby Bldg.
Wichita, Kansas 67202

WELL PLUGGING RECORD

Give All Information Completely
Make Required Affidavit

COUNTY Ellis SEC. 23 TWP. 14 RGE. 18 E/W
Location as in quarters or footage from lines:
SE SE SE

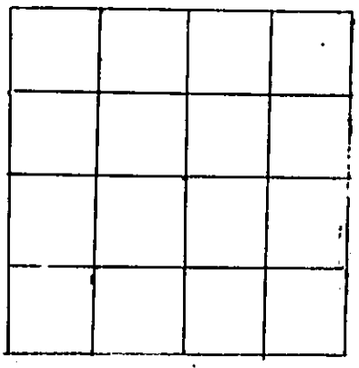

Locate Well correctly on above Section Platt.

Lease Owner N - B Company, Inc.
Lease Name Binder Well No. 1
Office Address P. O. Box 506, Russell, KS 67665
Character of Well (Completed as Oil, Gas or Dry Hole): Dry hole
Date Well Completed 1-23-82
Application for plugging filed 1-23-82
Plugging commenced 1-23-82
Plugging completed 1-23-82
Reason for abandonment of well or producing formation
Dry hole
Was permission obtained from the Conservation Division or it's Agent's before plugging was commenced? Yes

Name of Conservation Agent who supervised plugging of this well Gilbert Scheck
Producing formation Depth to top bottom T.D.
Show depth and thickness of all water, oil and gas formations.

OIL, GAS OR WATER RECORDS — Casing Record

Formation	Content	From	To	Size	Put in	Pulled Out
				8-5/8	252'	-0-

Describe in detail the manner in which the well was plugged, indicating where the mud fluid was placed and the method or methods used in introducing it into the hold. If cement or other plugs were used, state the character of same and depth placed, from feet to feet for each plug set.

Mud laden fluid @ 3552' - 1143'
50 sks cement @ 1143'
40 sks cement @ 750'
40 sks cement @ 240'
10 sks cement @ 40'
10 sks cement in rat hole.

RECEIVED
STATE CORPORATION COMMISSION
JAN 26 1982
01-26-82
CONSERVATION DIVISION
Wichita, Kansas

(If additional description is necessary, use BACK of this sheet)
Name of Plugging Contractor Emphasis Oil Operations

STATE OF KANSAS COUNTY OF RUSSELL, ss.
Joe K. Branum (employee of owner) or (owner or operator) of the above-described well, being first duly sworn on oath, says: That I have knowledge of the facts, statements, and matters herein contained and the log of the above-described well as filed and that the same are true and correct. So help me God.

(Signature) Joe K. Branum
P.O. Box 506, Russell, KS 67665
(Address)

SUBSCRIBED AND SWORN TO before me this 25th day of January, 19 82

Joyce Ann Ridgley
Notary Public.

My Commission expires: April 29, 1984.

NOTARY PUBLIC KANSAS
JOYCE ANN RIDGLEY
Russell County, Kansas
My Appt. Exp. 4-29-84

15-051-22763-00-00

EMPHASIS OIL OPERATIONS
P. O. Box 506
Russell, Kansas 67665

DRILLERS LOG

OPERATOR: N - B Company, Inc.
P. O. Box 506
Russell, Kansas 67665

CONTRACTOR: Emphasis Oil Operations
P. O. Box 506
Russell, Kansas 67665

LEASE: Binder WELL: #1

LOCATION: SE SE SE
Section 23-14S-18W
Ellis County, Kansas

Total Depth: 3552'

Elevation: 1949' gr.

Commenced: 1-14-82

Completed: 1-23-82

Casing: 8-5/8" @ 252' with 175 sks cement

Status: Dry Hole

RECEIVED
CONSERVATION DIVISION

DEPTHS & FORMATIONS

(All measurements from K.B.)

Top soil & sand	40'	Sand & shale	1585'
Sand	959'	Shale	1950'
Sand & shale	1142'	Shale & lime (R.T.D.)	3552'
Anhydrite	1188'		

STATE OF KANSAS)
ss:
COUNTY OF RUSSELL)

I, Joe K. Branum, of Emphasis Oil Operations, state that the above and foregoing is a true and correct log of the above captioned well.

Joe K. Branum

Subscribed and sworn to before me this 25th day of January, 1982.

My Commission Expires: April 29, 1984.

JOYCE ANN RIDGLEY
Russell County, Kansas
My Appt. Exp. 4-29-84

Joyce Ann Ridgley
Notary Public