

CARD MUST BE TYPED

State of Kansas
NOTICE OF INTENTION TO DRILL
(see rules on reverse side)

CORRECTION
CARD MUST BE SIGNED

Starting Date: July 23, 1985
month day year

API Number 15- 167-22,637-00-00
* "CORRECTED INTENT"

OPERATOR: License # 7482
Name Jerry J. Driscoll Oil Investment, Inc.
Address P.O. Box 921
City/State/Zip Russell, Kansas 67665
Contact Person Jerry J. Driscoll
Phone (913)-483-2416

NE SW SW Sec 8 Twp 14 S Rge 12
(location) East West

990 Ft North from Southeast Corner of Section
4290 Ft West from Southeast Corner of Section
(Note: Locate well on Section Plat on reverse side)

CONTRACTOR: License # 8241
Name Emphasis Oil Operations
City/State P.O. Box 506, Russell, KS 67665-0506

Nearest lease or unit boundary line 990 feet.
County Russell

* Lease Name Mahoney Well# 2

Well Drilled For: Well Class: Type Equipment:
 Oil Swd Infield Mud Rotary
 Gas Inj Pool Ext. Air Rotary
 OWWO Expl Wildcat Cable

Domestic well within 330 feet: yes no
Municipal well within one mile: yes no

If OWWO: old well info as follows:

Operator
Well Name
Comp Date Old Total Depth
Projected Total Depth 3325 feet
Projected Formation at TD Arbuckle
Expected Producing Formations Lansing-KC, Arbuckle

Depth to Bottom of fresh water 60 feet
Lowest usable water formation Dakota
* Depth to Bottom of usable water 280 feet

* Surface pipe by Alternate: 1 2
* Surface pipe to be set 331 feet
Conductor pipe if any required N/A feet
Ground surface elevation 1825 feet MSL

This Authorization Expires 1-19-86
Approved By RCH 7-25-85 DRIG RCUO 7-19-85

I certify that we will comply with K.S.A. 55-101, et seq., plus eventually plugging hole to K.C.C. specifications.

* WAS: Mahoney #1
450' to usable water
surf pipe by Alt 2
surf pipe to be set 300'


Date 7-24-85 Signature of Operator or Agent

Agent

Must be filed with the K.C.C. five (5) days prior to commencing well
This card void if drilling not started within six (6) months of date received by K.C.C.

Important procedures to follow :

**A Regular Section of Land
1 Mile = 5,280 Ft.**

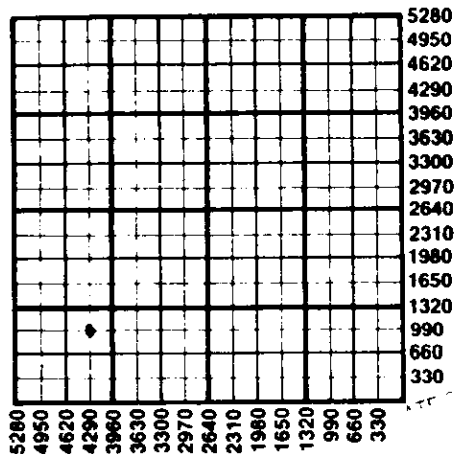

1. Notify District office before setting surface casing.
2. Set surface casing by circulating cement to the top.
3. File completion forms ACO-1 with K.C.C. within 90 days of well completion, following instructions on ACO-1, side 1, and including copies of wireline logs.
4. Notify District office 48 hours prior to old well workover or re-entry.
5. Prior to plugging, prepare a plugging plan, then obtain agreement from the appropriate district office for an approved plugging plan.
6. Submit plugging report (CP-4) to K.C.C. after plugging is completed.
7. Obtain an approved injection docket number before disposing of salt water.
8. Notify K.C.C. within 10 days when injection commences or terminates.
9. If an alternate 2 completion, cement in the production pipe from below any usable water to surface within 120 days of spud date.

RECEIVED
JUL 25 1985
07-25-1985
STATE CORPORATION COMMISSION
WICHITA, KANSAS

State Corporation Commission of Kansas
Conservation Division
200 Colorado Derby Building
Wichita, Kansas 67202
(316) 263-3238