


Give All Information Completely  
Make Required Affidavit  
Mail or Deliver Report to:  
Conservation Division  
State Corporation Commission  
212 North Market, Insurance Bldg.  
Wichita, Kansas

Location as "NE/CNW/SW" or footage from lines Ellis County. Sec. 36 Twp. 13 Rge. (E) 20 (W)  
Lease Owner ALCO OIL AND GAS CORPORATION  
Lease Name Engel "A" Well No. 1 SWD  
Office Address P.O. Box 52027, Lafayette, Louisiana 70501  
Character of Well (completed as Oil, Gas or Dry Hole) SWD  
Date well completed March 18 1957  
Application for plugging filed June 6 1968  
Application for plugging approved June 7 1968  
Plugging commenced June 8 1968  
Plugging completed June 8 1968  
Reason for abandonment of well or producing formation \_\_\_\_\_

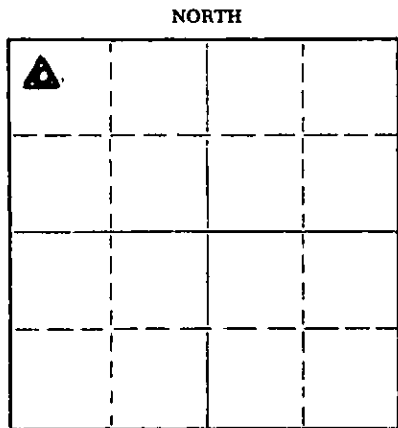

Locate well correctly on above Section Plat

If a producing well is abandoned, date of last production \_\_\_\_\_ 19\_\_\_\_  
Was permission obtained from the Conservation Division or its agents before plugging was commenced? Yes

Name of Conservation Agent who supervised plugging of this well Leo Massey  
(Injection) Arbuckle formation Depth to top \_\_\_\_\_ Bottom \_\_\_\_\_ Total Depth of Well 3960 Feet  
Show depth and thickness of all water, oil and gas formations.

OIL, GAS OR WATER RECORDS

CASING RECORD

FORMATION	CONTENT	FROM	TO	SIZE	PUT IN	PULLED OUT
				10	195	-0-
				5 1/2	3870	-0-

Describe in detail the manner in which the well was plugged, indicating where the mud fluid was placed and the method or methods used in introducing it into the hole. If cement or other plugs were used, state the character of same and depth placed, from \_\_\_\_\_ feet to \_\_\_\_\_ feet for each plug set.

5 sxs cottonseed hulls on bottom across open hole in Arbuckle Fm followed by  
40 sxs gel followed by  
100 sxs of 50-50 pozmix cement, top of cement estimated to be 3200'

RECEIVED  
STATE CORPORATION COMMISSION  
JUN 20 1968  
CONSERVATION DIVISION  
Wichita, Kansas

(If additional description is necessary, use BACK of this sheet)  
Name of Plugging Contractor Company Tools  
Address \_\_\_\_\_

STATE OF Louisiana Parish Parish COUNTY OF Lafayette, ss.  
Michael R. Simon (employee of owner) or (owner or operator) of the above-described well, being first duly sworn on oath, says: That I have knowledge of the facts, statements, and matters herein contained and the log of the above-described well as filed and that the same are true and correct. So help me God

(Signature) Michael R. Simon  
P.O. Box 52027, Lafayette, La. 70501  
(Address)

SUBSCRIBED AND SWORN TO before me this 13th day of June, 1968

My commission expires with life \_\_\_\_\_ Notary Public.

