


STATE OF KANSAS
STATE CORPORATION COMMISSION

Form CP-4

Give All Information Completely
Make Required Affidavit
Mail or Deliver Report to:
Conservation Division
State Corporation Commission
212 No. Market
Wichita, Kansas 67202

15-051-19103-0001
WELL PLUGGING RECORD

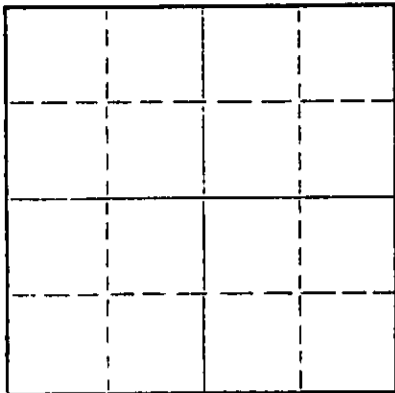

Locate well correctly on above
Section Plat

Ellis County. Sec. 36 Twp. 13S Rge. 20W (E) W (W)
Location as "NE/CNWxSWx" or footage from lines C S/2 S/2 NW NW
Lease Owner G. N. Rupe
Lease Name Engel (formerly Natl Well No. 2)
Office Address 925 O. W. Garvey Bldg., 200 W. Douglas, Wichita, Kansas
Character of Well (completed as Oil, Gas or Dry Hole) Oil
Date well completed July 26, 1962
Application for plugging filed April 5, 1974
Application for plugging approved April 8, 1974
Plugging commenced May 2, 1974
Plugging completed May 2, 1974
Reason for abandonment of well or producing formation not in use

If a producing well is abandoned, date of last production 19
Was permission obtained from the Conservation Division or its agents before plugging was commenced? yes

Name of Conservation Agent who supervised plugging of this well Leo Massey
Producing formation _____ Depth to top _____ Bottom _____ Total Depth of Well _____ Feet
Show depth and thickness of all water, oil and gas formations.

OIL, GAS OR WATER RECORDS

CASING RECORD

FORMATION	CONTENT	FROM	TO	SIZE	PUT IN	PULLED OUT
						none

Describe in detail the manner in which the well was plugged, indicating where the mud fluid was placed and the method or methods used in introducing it into the hole. If cement or other plugs were used, state the character of same and depth placed, from _____ feet to _____ feet for each plug set.

Pumped 1/2 sack hulls and 80 sacks 50/50 Pozmix and 6% gel, followed w/ 25 sacks Gel.
Used Wood plugs. Pressure from 0 to 1500 psig.

RECEIVED
STATE CORPORATION COMMISSION
MAY 20 1974
520-74
CONSERVATION DIVISION
Wichita, Kansas

(If additional description is necessary, use BACK of this sheet)
Name of Plugging Contractor Company Tools (G. N. Rupe)
Address 925 O. W. Garvey Bldg., 200 West Douglas, Wichita, Kansas

STATE OF Kansas, COUNTY OF Sedgwick, ss.
John Cecil, Jr. (employee of owner) or (owner or operator) of the above-described well, being first duly sworn on oath, says: That I have knowledge of the facts, statements, and matters herein contained and the log of the above-described well as filed and that the same are true and correct. So help me God.

(Signature) John Cecil Jr
Rt 2 Larned Kans 67550
(Address) 74

SUBSCRIBED AND SWORN TO before me this 16th day of May, 1974

Faye W. Leach
Faye W. Leach
Notary Public.

My commission expires September 16, 1977

KANSAS GEOLOGICAL SOCIETY
 KANSAS WELL LOG BUREAU - KANSAS WELL SAMPLE BUREAU
 KANSAS GEOLOGICAL SOCIETY BUILDING
 508 EAST MURDOCK - WICHITA, KANSAS

COMPANY **A. Runnel & National Drilling**

BEC. 36 T. 13S R. 20W

FARM **Engel**

NO. 2

LOC.

C S/2 S/2 NW NW

TOTAL DEPTH **3846**

COUNTY **Ellis**


COMM. **6/21/62**

COMP. **7/26/62**

KANSAS

SHOT OR TREATED

CONTRACTOR **National Drilling Company**

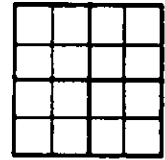

ISSUED

01
15-051-19103-00-~~01~~

CASING

20 10
 15 8" 205/150 sx.
 12 6
 13 5
 4" 3842'

ELEVATION **2203 KB**

PRODUCTION **Oil Well**

FIGURES INDICATE BOTTOM OF FORMATIONS

Log Tops:

Anhydrite	1506'	+692'
Topeka	3204	-1006'
Heebner	3457	-1259'
Toronto	3477'	-1279'
Lansing	3498'	-1300'
B/Kansas City	3746'	-1548'
Marmaton	3778'	-1580'
Arbuckle	3838'	-1640'
TD	3846'	-1648'.

RECEIVED
 STATE CORPORATION COMMISSION
APR 8 - 1974
 CONSERVATION DIVISION
 Wichita, Kansas