

Give All Information Completely
Make Required Affidavit
Mail or Deliver Report to:
Conservation Division
State Corporation Commission
212 No. Market
Wichita, Kansas

WELL PLUGGING RECORD

15-051-20191-00-00

Ellis County, Sec. 35 Twp. 13 Rge. (E) 20W

Location as "NE/CNW/SW" or footage from lines SW NW NW

Lease Owner Cameron K. Reed

Lease Name Storm "C" Well No. 1

Office Address P. O. Box 2 Chanute, Kansas

Character of Well (completed as Oil, Gas or Dry Hole) oil

Date well completed December 23 19 67

Application for plugging filed July 12, 19 73

Application for plugging approved July 12, 19 73

Plugging commenced July 13 @ 11:00 A. M. 19 73


Plugging completed July 13, 2:45 P. M. 19 73

Reason for abandonment of well or producing formation

Depleted oil zone

If a producing well is abandoned, date of last production July, 1972 & 6/1973

Was permission obtained from the Conservation Division or its agents before plugging was commenced? yes

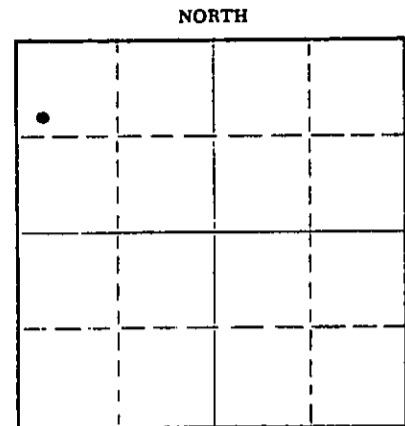

Locate well correctly on above Section Plat

Name of Conservation Agent who supervised plugging of this well Leo Massey - Hays, Kansas

Producing formation Arbuckle Depth to top 3850 Bottom 3862 Total Depth of Well 3862 Feet

Show depth and thickness of all water, oil and gas formations.

OIL, GAS OR WATER RECORDS

CASING RECORD

FORMATION	CONTENT	FROM	TO	SIZE	PUT IN	PULLED OUT
Soil, lime & Shale		0	208	8 5/8"	208	None
Lime & shale		0	3850	4 1/2"	3850	none

Describe in detail the manner in which the well was plugged, indicating where the mud fluid was placed and the method or methods used in introducing it into the hole. If cement or other plugs were used, state the character of same and depth placed, from _____ feet to _____ feet for each plug set.

Well squeezed @ 1200' w/250 sax 8-30-68
Well squeezed @ 910' - 1200 w/250 sax 6-1-72

Ran 2945' of 2 3/8" tubing inside casing
Mixed and pumped in 20 sax gel
Spotted 40 sax - 2360 - 2945 circ. gel
Spotted 20 sax 1230 - 1525 circ. gel
Spotted 65 sax 0 - 600 circ. gel

RECEIVED
STATE CORPORATION COMMISSION

JUL 18 1973
7-18-73
CONSERVATION DIVISION
Wichita, Kansas

RECEIVED
STATE CORPORATION COMMISSION

JUL 30 1973
CONSERVATION DIVISION
Wichita, Kansas

(If additional description is necessary, use BACK of this sheet)

Name of Plugging Contractor Company tools - Shirk Well Service & Halliburton

Address Hays and Ellis, Kansas

STATE OF KANSAS COUNTY OF NEOSHO, ss.

James E. Guinotte (employee of owner) or (owner or operator) of the above-described well, being first duly sworn on oath, says: That I have knowledge of the facts, statements, and matters herein contained and the log of the above-described well as filed and that the same are true and correct. So help me God.

(Signature) James E. Guinotte

P. O. Box 2 Chanute, Kansas (Address)

SUBSCRIBED AND SWORN TO before me this 17th day of July, 19 73

Bereldine Dunivant

My commission expires Feb. 5, 1974

Notary Public.

W E L L L O G

OPERATOR: DANE G HANSEN TR 15-051-20191-00-00
WELL NAME: STORM C#1 LOCATION: SW NW NW SEC 35-13-20W
COUNTY: ELLIS STATE: KANSAS
WELL COMMENCED: DEC. 23, 1967 WELL COMPLETED: JAN 2, 1968
ELEVATION: 2217 KB TOTAL DEPTH: 3855'
PRODUCTION: PRODUCING RIG NO: 1
CASING - 8-5/8": 10 JTS. 208.42' CASING W/140 SACKS POZMIX CEMENT
~~8-5/8"~~ 4 1/2" NEW CASING 120 JTS 3874.33' W/125 SACKS POZMIX CEMENT

All Measurements taken from the top of rotary bushing.

FROM	TO	FORMATION	DEVIATION FROM VERTICAL	REMARKS:
208	505	SHALE	1 1/2° 500'	DST #1 3850-3855
505	570	SAND	1° 1000'	
570	995	SHALE	1° 1500'	
995	1200	SAND	0° 2000'	
1200	1445	RED BED	1/2° 2500'	
1445	1525	RED BED & SHALE	1-3/4° 3510'	
1525	1568	ANHYDRITE		
1568	1760	SHALE & SHELL		
1760	2090	SHALE		
2090	3495	SHALE & LIME		
3495	3850	LIME		
3850	3855	ARBUCKLE		

RECEIVED
STATE CORPORATION COMMISSION
CONSERVATION DIVISION
Wichita, Kansas


STATE OF KANSAS
COUNTY OF SEDGWICK) SS:

The undersigned hereby certifies that to the best of his knowledge and belief, the above facts are true and correct.

C-G DRILLING CO.

By G. F. Galloway
G. F. GALLOWAY


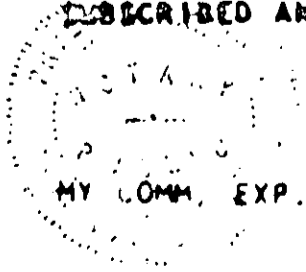

Phyllis Buchanan
PHYLLIS BUCHANAN - NOTARY PUBLIC