

All Information Completely
Required Affidavit
For Deliver Report to:
Conservation Division
State Corporation Commission
211 No. Broadway
Wichita, Kansas

WELL PLUGGING RECORD

15-051-04317-00-00

Ellis County, Sec. 35 Twp. 13S Rge. 20W (X) (W)

Location as "NE/CNW&SW" or footage from lines NW NE SW

Lease Owner Leben Drilling, Inc.

Lease Name Dreiling Well No. 2

Office Address P. O. Box 486, Great Bend, Kansas

Character of Well (completed as Oil, Gas or Dry Hole) Dry Hole

Date well completed 4-11-63 19

Application for plugging filed 4-11-63 19

Application for plugging approved 4-11-63 19


Plugging commenced 4-11-63 19

Plugging completed 4-11-63 19

Reason for abandonment of well or producing formation Dry Hole

If a producing well is abandoned, date of last production _____ 19

Was permission obtained from the Conservation Division or its agents before plugging was commenced? yes

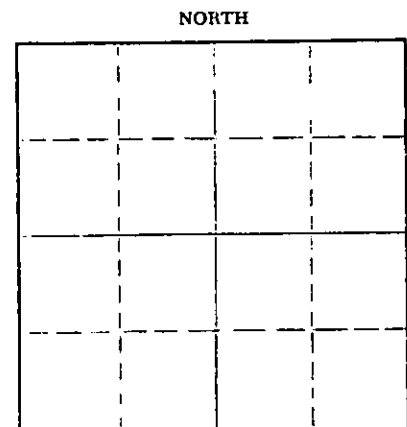

Name of Conservation Agent who supervised plugging of this well Eldon Petty, Hays, Kansas

Producing formation _____ Depth to top _____ Bottom _____ Total Depth of Well 3839' Feet

Show depth and thickness of all water, oil and gas formations.

OIL, GAS OR WATER RECORDS

CASING RECORD

FORMATION	CONTENT	FROM	TO	SIZE	PUT IN	PULLED OUT
				8 5/8"	230'	none

Describe in detail the manner in which the well was plugged, indicating where the mud fluid was placed and the method or methods used in introducing it into the hole. If cement or other plugs were used, state the character of same and depth placed, from _____ feet to _____ feet for each plug set.

Mud to 600', plug with 1/2 sk. hulls and 20 sks. cement
Mud to 210', plug with 1/2 sk. hulls and 20 sks. cement
Mud to 40', plug with 1/2 sk. hulls and 10 sks. cement to bottom of cellar.

RECEIVED
STATE CORPORATION COMMISSION

APR 17 1963

CONSERVATION DIVISION
Wichita, Kansas

(If additional description is necessary, use BACK of this sheet)

Name of Plugging Contractor Leben Drilling, Inc.
Address P. O. Box 486, Great Bend, Kansas

STATE OF KANSAS, COUNTY OF BARTON, ss.
Leslie Kite (employee of owner) or (owner or operator) of the above-described well, being first duly sworn on oath, says: That I have knowledge of the facts, statements, and matters herein contained and the log of the above-described well as filed and that the same are true and correct. So help me God.

(Signature) Leslie Kite
P. O. Box 486, Great Bend, Kansas
(Address)

SUBSCRIBED AND SWORN TO before me this 15th day of April, 19 63

My commission expires April 1, 1967 Ulanda Nichols Notary Public.

DRILLER'S LOG

COMPANY: Leben Drilling, Inc.
 CONTRACTOR: LEBEN DRILLING, INC.
 FARM: DREILING #2
 LOCATION: NW NE SW Sec. 35-13S-20W
 ELLIS COUNTY, KANSAS
 COMMENCED: 4-1-63
 COMPLETED: 4-11-63

15:05:0437:00:00

0	50	Post Rock
50	230	Sand & Shale
230	880	Shale
880	1480	Shale & Sand
1480	1510	Anhydrite
1510	1880	Shale
1880	2235	Shale & Lime
2235	2590	Lime & Shale
2590	2835	Lime
2835	3300	Lime & Shale
3300	3385	Shale & Lime
3385	3487	Lime & Shale
3487	3555	Lime
3555	3595	Lime & Shale
3595	3814	Lime
3814	3839	Lime & Chert
	<u>3839</u>	<u>Rotary Total Depth - D. & A.</u>

STATE CORPORATION COMMISSION

APR 17 1963

CONSERVATION DIVISION
 Wichita, Kansas

Set 8 5/8" used surface casing @ 230' Cemented with 160 sacks Sunset.

I, Leslie Kite, do hereby certify that the above and foregoing is a true and correct copy of the log of the Dreiling #2, located NW NE SW of Section 35, Township 13 South, Range 20 West, Ellis County, Kansas, as reflected by the files of Leben Drilling, Inc.

Leslie Kite
 Leslie Kite

STATE OF KANSAS)
)
 COUNTY OF BARTON) SS

Subscribed and sworn to before me, a Notary Public, in and for Barton County, Kansas, this 15th day of April, 1963.

Ulanda Nichols
 Ulanda Nichols, Notary Public

My Commission Expires:
 April 1, 1967