

Give All Information Completely
Make Required Affidavit
Mail or Deliver Report to:
Conservation Division
State Corporation Commission
311 No. Broadway
Wichita, Kansas


WELL PLUGGING RECORD^R

15-051-303040000

ELLIS County. Sec. 35 Twp. 13 Rge. 20 (E) W (W)

Location as "NE/CNW/SW" or footage from lines N/2 S/2 NW/4
Lease Owner DANE G HANSEN ESTATE
Lease Name STORM "A" Well No. 2
Office Address LOGAN, KANSAS
Character of Well (completed as Oil, Gas or Dry Hole) DRY HOLE
Date well completed JANUARY 20 19 66
Application for plugging filed JANUARY 20 19 66
Application for plugging approved JANUARY 20 19 66
Plugging commenced JANUARY 20 19 66
Plugging completed JANUARY 21 19 66
Reason for abandonment of well or producing formation TOO LOW STRUCTURALLY

NORTH

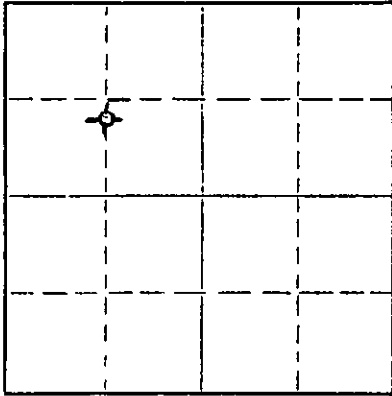

Locate well correctly on above
Section Plat

If a producing well is abandoned, date of last production _____ 19 ____
Was permission obtained from the Conservation Division or its agents before plugging was commenced? YES

Name of Conservation Agent who supervised plugging of this well GILBERT LEIKER
Producing formation _____ Depth to top _____ Bottom _____ Total Depth of Well 3853 Feet
Show depth and thickness of all water, oil and gas formations.

OIL, GAS OR WATER RECORDS

CASING RECORD

FORMATION	CONTENT	FROM	TO	SIZE	PUT IN	PULLED OUT
				8-5/8"	212.95'	NONE

Describe in detail the manner in which the well was plugged, indicating where the mud fluid was placed and the method or methods used in introducing it into the hole. If cement or other plugs were used, state the character of same and depth placed, from _____ feet to _____ feet for each plug set.

FILLED WITH HEAVY MUD TO 540'. SET PLUG. PUT IN 20 SACKS CEMENT. FILLED WITH HEAVY MUD TO 200'. SET PLUG. PUT IN 25 SACKS CEMENT. FILLED WITH HEAVY MUD TO 40'. SET PLUG. FILLED TO TOP WITH 1/2 SACKS HULLS AND 10 SACKS CEMENT.

1-31-66
JAN 31 1966


Name of Plugging Contractor C-G DRILLING CO. (If additional description is necessary, use BACK of this sheet)
Address 107 RULE BUILDING, WICHITA 2, KANSAS

STATE OF KANSAS COUNTY OF SEDGWICK, ss.
G. F. GALLOWAY (employee of owner) or ~~(owner)~~ of the above-described

well, being first duly sworn on oath, says: That I have knowledge of the facts, statements, and matters herein contained and the log of the above-described well as filed and that the same are true and correct. So help me God.

(Signature) Jay H Galloway
JAY H. GALLOWAY 107 RULE BUILDING
(Address)

SUBSCRIBED AND SWORN to before me this 24th day of JANUARY 19 66

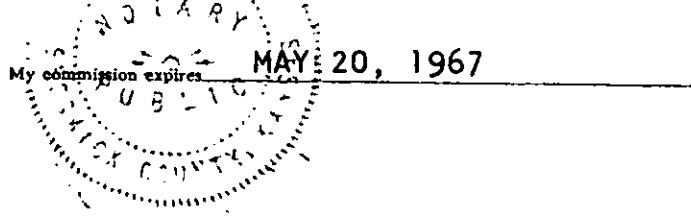

Vicky Jacobs
VICKY JACOBS Notary Public.

W E L L L O G

OPERATOR: DANE G. HANSEN ESTATE 15:051-3030400:00
 WELL NAME: STORM"A"#2 LOCATION: N/2 S/2 NW/35-13-20W
 COUNTY: ELLIS STATE: KANSAS
 WELL COMMENCED: JAN. 12 1966 WELL COMPLETED: JAN. 21, 1966
 ELEVATION: 2188 KB TOTAL DEPTH: 3853'
 PRODUCTION: DRY & ABANDONED RIG NO: #1
 CASING - 8-5/8": 11 JOINTS, 212.95' W/130 sacks common cement & 2 c. ch.
 5-1/2": _____

All Measurements taken from the top of rotary bushing.

FROM	TO	FORMATION	DEVIATION FROM VERTICAL	REMARKS:
0	212	SAND	3/4°	245'
212	555	SHALE	3/4°	500'
555	850	SAND & SHALE	1°	1070'
850	950	SHALE	1°	1570'
950	1165	SAND	1 1/4°	2000'
1165	1310	RED BED & SHALE	1-3/4°	2270'
1310	1494	RED BED	1-3/4°	2350'
1494	1530	ANHYDRITE	1-1/2°	2430'
1530	2040	SHALE & SHELLS	1°	2470'
2040	3435	LIME & SHALE	1°	2570'
3435	3790	LIME	1°	3055'
3790	3830	LIME & SHALE		
3830	3853	LIME		

RECEIVED

JAN 31 1966

CONSERVATION DIVISION
Wichita, Kansas

STATE OF KANSAS }
 COUNTY OF SEDGWICK } SS:

The undersigned hereby certifies that to the best of his knowledge and belief, the above facts are true and correct.

G-G DRILLING CO.

By John H. Bellamy

24th JANUARY 1966.

Wicky Jacobs

