


STATE OF KANSAS  
STATE CORPORATION COMMISSION

Give All Information Completely  
Make Required Affidavit  
Mail or Deliver Report to:  
Conservation Division  
State Corporation Commission  
212 No. Market  
Wichita, Kansas

WELL PLUGGING RECORD

NORTH

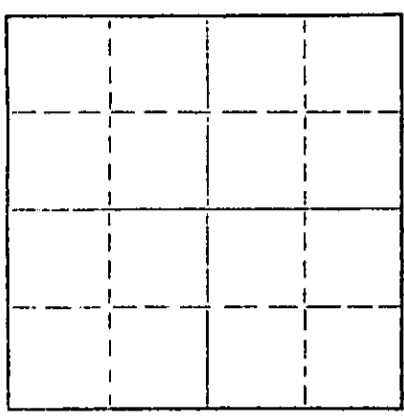

Gove County, Sec. 31 Twp. 14 Rge. 27W ~~XXXXXXXXXX~~  
 Location as "NE/CNW/SE/SW" or footage from lines. S/2 S/2 SW  
 Lease Owner DONALD C. SLAWSON  
 Lease Name Coberly 'GGG' Well No. 1  
 Office Address 200 Douglas Building Wichita, Kansas 67202  
 Character of Well (completed as Oil, Gas or Dry Hole) dry hole  
 Date well completed June 9 1978  
 Application for plugging filed June 9 1978  
 Application for plugging approved June 9 1978  
 Plugging commenced June 9 1978  
 Plugging completed June 9 1978  
 Reason for abandonment of well or producing formation dry hole

If a producing well is abandoned, date of last production 19\_\_\_\_  
 Was permission obtained from the Conservation Division or its agents before plugging was commenced? YES

Name of Conservation Agent who supervised plugging of this well Gilbert Balthazor  
 Producing formation \_\_\_\_\_ Depth to top \_\_\_\_\_ Bottom \_\_\_\_\_ Total Depth of Well 4250 Feet  
 Show depth and thickness of all water, oil and gas formations.

OIL, GAS OR WATER RECORDS

CASING RECORD

FORMATION	CONTENT	FROM	TO	SIZE	PUT IN	PULLED OUT
	292.65	surface	289'	8 5/8"		

Describe in detail the manner in which the well was plugged, indicating where the mud fluid was placed and the method or methods used in introducing it into the hole. If cement or other plugs were used, state the character of same and depth placed, from \_\_\_\_\_ feet to \_\_\_\_\_ feet for each plug set.

1st plug @ 900' w/70 sx  
 2nd plug @ 250' w/20 sx  
 3rd plug @ 40' w/10 sx

08-16-78


(If additional description is necessary, use BACK of this sheet)  
 Name of Plugging Contractor Slawson Drilling Co., Inc.  
 Address 200 Douglas Bldg. Wichita, Kansas 67202

STATE OF KANSAS, COUNTY OF SEDGWICK, ss.  
 R. J. THATCHER (employee of owner) or (owner or operator) of the above-described well, being first duly sworn on oath, says: That I have knowledge of the facts, statements and matters herein contained and the log of the above-described well as filed and that the same are true and correct. So help me God.

(Signature) *R. J. Thatcher*  
 R. J. THATCHER, Engineer 200 Douglas Bldg.  
 (Address) Wichita, KS 67202

SUBSCRIBED AND SWORN to before me this 10th day of August, 1978

My commission expires 6/12/82  
 Sherry Milford Notary Public.

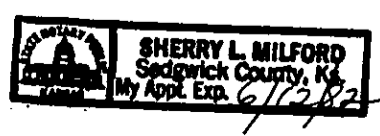

WELL LOG

OPERATOR: DONALD C. SLAWSON  
 200 Douglas Building  
 Wichita, Kansas 67202

LEASE: #1 Coberly 'GGG'  
 S/2 S/2 SW Sec. 31-14-27W  
 Gove County, Kansas

CONTRACTOR: SLAWSON DRILLING COMPANY  
 200 Douglas Building  
 Wichita, Kansas 67202

COMMENCED: June 1, 1978

COMPLETED: June 9, 1978

CASING: Surface - 8 5/8" @ 289' w/175 sx 60/40 poz

0 - 294	Surface hole
294 - 1095	Shale and shells
1095 - 1961	Shale, sand & shells
1961 - 1988	Anhydrite
1988 - 2404	Shale and lime
2404 - 2716	Shale and shells
2716 - 3922	Shale and lime
3922 - 4250	Lime
4250	RTD

STATE OF KANSAS  
 AUG 16 1978  
 COMMISSIONER OF REVENUE

STATE OF KANSAS            )  
                                   )        SS.  
 COUNTY OF SEDGWICK        )

I, R. J. THATCHER, of the Slawson Drilling Company, Inc. upon oath state that the above and foregoing is a true and correct copy of the log on the #1 Coberly 'GGG' test.

*R. J. Thatcher*  
 R. J. THATCHER, Engineer

Subscribed and sworn to before me this 10th day of August, 1978.

*Sherry L. Milford*  
 Sherry Milford, Notary Public

My Commission Expires: 6/12/82

