


Give All Information Completely
Make Required Affidavit
Mail or Deliver Report to:
Conservation Division
State Corporation Commission
800 Biting Building
Wichita, Kansas

OR
FORMATION PLUGGING RECORD

Strike out upper line
when reporting plug-
ging off formations.

NORTH

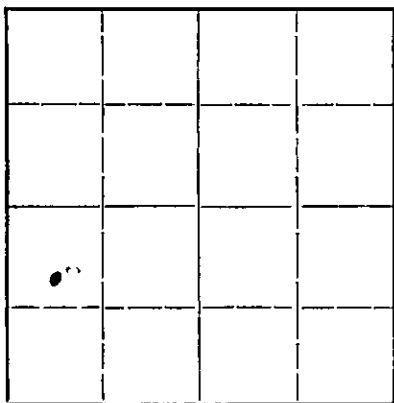

Locate well correctly on above
Section Flat

Russell County. Sec. 8 Twp. 14 Rge. 12 (E) (W)
Location as "NE $\frac{1}{4}$ NW $\frac{1}{4}$ SW $\frac{1}{4}$ " or footage from lines S. of SW $\frac{1}{4}$
Lease Owner Jones Brothers Drilling Company
Lease Name Mahoney Well No. 3
Office Address Cleveland, Oklahoma
Character of Well (completed as Oil, Gas or Dry Hole) Dry Hole
Date, well completed December 1 st. 1940
Application for plugging filed December 1 st. 1940
Application for plugging approved December 2 nd. 1940
Plugging Commenced December 2 nd. 1940
Plugging Completed December 9 th. 1940
Reason for abandonment of well or producing formation Hole full of water.

If a producing well is abandoned, date of last production 19
Was permission obtained from the Conservation Division or its agents before plugging was com-
menced? Yes

Name of Conservation Agent who supervised plugging of this well Mr. C.T. Alexander
Producing formation 1 st. break in K.C. Lime Depth to top 2999 Bottom 3017 Total Depth of Well 3017 Feet
Show depth and thickness of all water, oil and gas formations.

OIL, GAS OR WATER RECORDS

CASING RECORD

| Formation | Content | From | To | Size " | Put In | Pulled Out |
|-----------|---------------|------|------|--------|--------|------------|
| S and | Fresh water | 215 | 307 | 15 | 307 | All |
| Lime | 5 BW salty | 368 | 375 | 13" | 592 | All |
| Lime | 10 BW salty | 424 | 433 | 10" | 762 | All |
| Lime | 300 ft. salty | 445 | 452 | 8" | 2430 | All |
| Lime | 12 BW salty | 595 | 600 | 7" | 3003 | 2985 |
| Lime | 1 BW salty | 2030 | 2050 | | | |
| KC Lime | HFW | 3013 | 3017 | | | |
| Sand | Shoe of gas | 2307 | 2340 | | | |
| Sand | 1 M of gas | 2430 | 2440 | | | |

Describe in detail the manner in which the well was plugged, indicating where the mud fluid was placed and the method or methods used in introducing it into the hole. If cement or other plugs were used, state the character of same and depth placed, from feet to feet for each plug set.

Put in mud from 3017 ft. to 3013 ft. 3013 ft. to 2998 ft. cement plug. Ripped 7 in. and left in 118 ft. Filled hole with mud to 2460 ft. Finished pulling 7 in. Started 8 in., put in cement plug from 2460 ft. to 2415 ft. Put in 200 5 gal. buckets of mud and pulled 10 jts., and put in 150 buckets of mud. Pulled 10 jts. of 8 in., and mudded 2 hrs., using barrell of sand line. Finished pulling 8 in., and started 10 in., and mudded to 750 ft. Finished pulling 10 in. Started 13 in., and mudded to 500 ft., pulled 200 ft., of 10 in., and mudded to 300 ft. Pulled 1 jt., of 15 in., and put permanent bridge of limestone from 285 ft. to 270 ft. pulled 1 jt. of 15 in. Cemented to 260 ft. Finished pulling 15 in. mudded to 15 ft. Cemented to 8 ft. Mudded to surface. All of cement dumped in with bailor.

PLUGGING
FILE SEC 8-T14-R1200
BOOK PAGE 124 LINE 5

12-03-1940
DEC 3 '40
STATE CORP. COM.
WICHITA, KAN.

(If additional description is necessary, use BACK of this sheet)

Correspondence regarding this well should be addressed to Jones Brother Drilling Company
Address Cleveland, Oklahoma

STATE OF KANSAS, COUNTY OF Russell, ss.
C. E. Jones, V. (employee of owner) or (owner or operator) of the above-described well,
being first duly sworn on oath, says: That I have knowledge of the facts, statements, and matters herein contained and the log of the above-described well as filed and that the same are true and correct. So help me God.

(Signature) C. E. Jones

SUBSCRIBED AND SWORN to before me this 11th day of December, 1940

(Address) [Signature]
Notary Public.

My Commission Expires Sept. 20, 1947.
My commission expires

She 9-1940

15-167-D6640-00-00

JONES BROTHERS DRILLING CO.
WAGON # 3
Sec. 8-14-12 W

| | | | | | |
|--------|------|------------------|---------|------|------------------|
| 0 to | 30 | lime soft | 2062 to | 2070 | shale blue |
| 30 " | 105 | shale dark | 2070 " | 2085 | lime |
| 105 " | 120 | sand | 2085 " | 2145 | shale and shells |
| 120 " | 130 | shale light | 2145 " | 2170 | lime |
| 130 " | 350 | shale dark | 2170 " | 2200 | shale |
| 150 " | 270 | sand | 2200 " | 2327 | shale and shells |
| 270 " | 285 | sandy shale | 2327 " | 2340 | lime broken |
| 285 " | 339 | red rock | 2340 " | 2395 | shale |
| 339 " | 368 | shale | 2395 " | 2396 | lime |
| 368 " | 385 | sand | 2396 " | 2430 | sandy shale |
| 385 " | 415 | shale blue | 2430 " | 2440 | sand |
| 415 " | 424 | sandy shale | 2440 " | 2455 | slate |
| 424 " | 435 | sand | 2455 " | 2466 | lime |
| 433 " | 445 | slate black | 2466 " | 2480 | shale and shells |
| 445 " | 452 | sand | 2480 " | 2502 | lime shells |
| 452 " | 467 | shale blue | 2502 " | 2514 | lime |
| 467 " | 755 | red rock | 2514 " | 2530 | shale |
| 755 " | 792 | lime anhydrite | 2530 " | 2557 | lime shells |
| 792 " | 950 | red rock | 2557 " | 2590 | shale |
| 950 " | 993 | slate blue | 2590 " | 2615 | lime |
| 993 " | 1030 | red rock | 2615 " | 2625 | shale |
| 1030 " | 1150 | slate blue | 2625 " | 2632 | lime |
| 1150 " | 1412 | salt | 2632 " | 2640 | slate |
| 1412 " | 1435 | shale blue | 2640 " | 2647 | lime |
| 1435 " | 1435 | lime | 2647 " | 2656 | shale |
| 1435 " | 1441 | shale gray | 2656 " | 2768 | lime |
| 1441 " | 1450 | lime | 2768 " | 2771 | shale |
| 1450 " | 1485 | shale and shells | 2771 " | 2915 | lime |
| 1485 " | 1493 | lime | 2915 " | 2922 | shale light |
| 1493 " | 1495 | slate blue | 2922 " | 2935 | lime |
| 1495 " | 1505 | lime | 2935 " | 2940 | slate blue |
| 1505 " | 1540 | lime broken | 2940 " | 2945 | red rock |
| 1540 " | 1555 | red rock | 2945 " | 2954 | slate blue |
| 1555 " | 1570 | lime broken | 2954 " | 2956 | lime |
| 1570 " | 1585 | lime | 2956 " | 2975 | shale blue |
| 1585 " | 1605 | shale blue | 2975 " | 2989 | lime |
| 1605 " | 1630 | lime | 2989 " | 2994 | red rock |
| 1630 " | 1635 | shale | 2994 " | 2999 | shale blue |
| 1635 " | 1640 | lime | 2999 " | 3008 | lime hard |
| 1640 " | 1656 | shale gray | 3008 " | 3013 | lime |
| 1656 " | 1666 | red rock | 3013 " | 3017 | lime soft |
| 1666 " | 1808 | lime | | | |
| 1808 " | 1835 | shale | | | |
| 1835 " | 1845 | lime | | | |
| 1845 " | 1855 | shale | | | |
| 1855 " | 1875 | lime | | | |
| 1875 " | 1886 | shale gray | | | |
| 1886 " | 1921 | lime | | | |
| 1921 " | 1932 | shale gray | | | |
| 1932 " | 1950 | lime | | | |
| 1950 " | 1955 | red rock | | | |
| 1955 " | 1990 | shale and shells | | | |
| 1990 " | 2015 | lime | | | |
| 2015 " | 2030 | red rock | | | |
| 2030 " | 2062 | lime | | | |

Total depth 3017 feet

Water Record

Fresh Water 215 ft. to 307 ft.
3 Bailsers salt water 268 ft. to 275 ft.
10 Bailsers salt water 486 ft. to 490
HF 445 ft. to 452 ft.
1 1/2 Bailer salt water 59 ft. to 60 ft.
1 Bailer salt water 2000 ft. to 2000 ft.
3/4 Bailer salt water 2880 ft. to 2895 ft.
HF 3015 ft. to 3017 ft.

Gas Record

Show of gas 2007 ft. to 2010 ft.
1 M gas 2100 ft. to 2110 ft.

Casing record

15 in. 307 ft.
12 in. 493 ft.
10 in. 762 ft.
8 in. 2430 ft.
6 in. 3008 ft.

All pipe pulled
Left in 110 ft. 6 5/8 in. second hand

PLUGGING
FILE 56 8-14-12 W
BOOK PAGE 24 LINE 5

12-13-1940