

WELL PLUGGING RECORD

Give All Information Completely
Make Required Affidavit
Mail or Deliver Report to:
Conservation Division
State Corporation Commission
800 Blitting Building
Wichita, Kansas

Russell

County. Sec. 8 Twp. 14S Rge. 12W (W)

Location as "NE/CNW $\frac{1}{4}$ /SW $\frac{1}{4}$ " or footage from lines SE SE SW

Lease Owner Pinsker Supply Company

Lease Name Mahoney Well No. 1

Office Address 3255 N. Broadway, Wichita, Kansas

Character of Well (completed as Oil, Gas or Dry Hole) Abandoned Oil Well

Date well completed May 30, 1949 19

Application for plugging filed June 11, 1950 19

Application for plugging approved June 11, 1950 19


Plugging commenced June 24, 1950 19

Plugging completed July 5, 1950 19

Reason for abandonment of well or producing formation Oil depleted

If a producing well is abandoned, date of last production 19

Was permission obtained from the Conservation Division or its agents before plugging was commenced? Yes

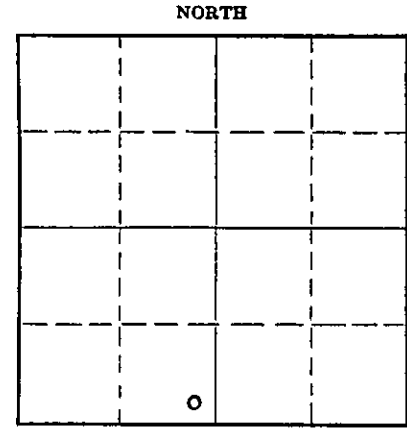

Locate well correctly on above Section Plat

Name of Conservation Agent who supervised plugging of this well Eldon Petty

Producing formation Lansing K. C. Depth to top 2928 Bottom 2979 Total Depth of Well 2979 Feet

Show depth and thickness of all water, oil and gas formations.

OIL, GAS OR WATER RECORDS

CASING RECORD

Formation	Content	From	To	Size	Put In	Pulled Out
				8-5/8"	150	
				5-1/2"	2960	181 1/2

Describe in detail the manner in which the well was plugged, indicating where the mud fluid was placed and the method or methods used in introducing it into the hole. If cement or other plugs were used, state the character of same and depth placed, from _____ feet to _____ feet for each plug set.

8-5/8" at 150 feet circulated with cement. 5 1/2" at 2960 feet. Filled with sand to 2950 feet. Set 5 sacks of cement with dump bailer. Pulled 181 1/2 feet of 5 1/2" casing and mudded hole to 150 feet. Set wood plug, rock and 15 sacks cement. Mudded hole to 35 feet; set rock bridge and 10 sacks of cement to bottom of cellar.

07-12-1950

(If additional description is necessary, use BACK of this sheet)

Correspondence regarding this well should be addressed to Pinsker Supply Company, 3255 N. Broadway, Wichita, Kansas

STATE OF KANSAS, COUNTY OF SEDGWICK, ss.

_____, (employee of owner) or (owner or operator) of the above-described well, being first duly sworn on oath, says: That I have knowledge of the facts, statements, and matters herein contained and the log of the above-described well as filed and that the same are true and correct. So help me God.

(Signature) Charles E. Oakes
Wichita, P.O. Box 1200, Kansas
(Address)

SUBSCRIBED AND SWORN TO before me this 12th day of July 1950

Seward J. Greife
Notary Public.

My commission expires Jan. 31, 1953

PLUGGING
JUL 14 1950
11-2

15-167-04981-00-00


WELL LOG BUREAU - KANSAS GEOLOGICAL SOCIETY
508 East Murdock, Wichita, Kansas

Company - W.M. STEINLE ETAL
Farm - Mahoney No. 1

SEC. 8 T. 14 R. 12W
SE SE SW

Total Depth. 2979
Comm. 5-20-49 Comp. 5-30-49
Shot or Treated.
Contractor. Lewis Drilling Co.
Issued. 1-21-50

County. Russell
KANSAS

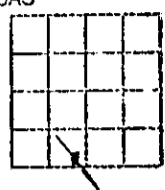

Elevation. _____

Production. dry

CASING:
8 5/8" 150'
5 1/2" 2960'

Figures Indicate Bottom of Formations.

sand, post rock	47
shale blue	270
sand, red bed	525
red bed	700
anhydrite	735
shale, shells	1125
salt, shale	1255
shale	1305
lime brwn	1450
lime brwn, shale,	
shells	1585
lime, shale	1715
lime brwn	1795
lime	1875
lime, shale	1975
lime brwn	2240
li. c, shale, shells	2335
shale, shells, lime	
brwn	2450
lime, shale	2600
lime brwn	2685
lime	2800
shale, shells	2845
lime, shale RTD	2965
lime	2979
Total Depth	

Tops:

Topeka lime	2580
Heobner shale	2850
Dodge	2871
Lansing K. C.	2928

T.D. 2979

FILE SEC 8 T. 14 R. 12W
BOOK PAGE 11 LINE 2

JUL 14 1950
06-14-1950