

15-1167-30132 00-100


STATE OF KANSAS  
STATE CORPORATION COMMISSION

Form CP-4

Give All Information Completely  
Make Required Affidavit  
Mail or Deliver Report to:  
Conservation Division  
State Corporation Commission  
212 No. Market  
Wichita, Kansas

WELL PLUGGING RECORD

Russell County. Sec. 10 Twp. 14S Rge. (E) 12 (W)  
Location as "NE/CNWxSWx" or footage from lines NW/4 NE/4 NE/4  
Lease Owner Forrest H. Lindsay - National Associated Petroleum  
Lease Name L. J. Witt Well No. 1  
Office Address Fifth Floor, Ritz Building, Tulsa, Oklahoma  
Character of Well (completed as Oil, Gas or Dry Hole) Dry Hole  
Date well completed October 21 19 65  
Application for plugging filed October 21 (verbal) 19 65  
Application for plugging approved October 21 (verbal) 19 65  
Plugging commenced October 21 19 65  
Plugging completed October 21 19 65  
Reason for abandonment of well or producing formation Dry Hole

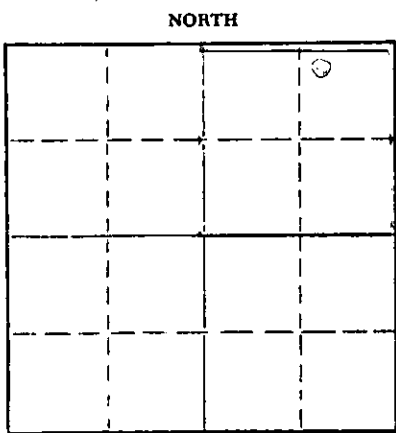

Locate well correctly on above  
Section Plat

If a producing well is abandoned, date of last production 19  
Was permission obtained from the Conservation Division or its agents before plugging was commenced? Yes

Name of Conservation Agent who supervised plugging of this well \_\_\_\_\_  
Producing formation \_\_\_\_\_ Depth to top \_\_\_\_\_ Bottom \_\_\_\_\_ Total Depth of Well 3418 Feet  
Show depth and thickness of all water, oil and gas formations.

OIL, GAS OR WATER RECORDS

CASING RECORD

FORMATION	CONTENT	FROM	TO	SIZE	PUT IN	PULLED OUT

Describe in detail the manner in which the well was plugged, indicating where the mud fluid was placed and the method or methods used in introducing it into the hole. If cement or other plugs were used, state the character of same and depth placed, from \_\_\_\_\_ feet to \_\_\_\_\_ feet for each plug set.

Mud to 310'  
1/2 sack hulls plug 25 sacks cement  
Mud to 40' - 1/2 sack hulls plug and cemented  
to top - 4 sacks in rat hole

APR 23 1966  
04-13-1966  
CONSERVATION DIVISION  
WICHITA, KANSAS

(If additional description is necessary, use BACK of this sheet)  
Name of Plugging Contractor Thoroughbred Drilling Company  
Address 517 Ritz Building, Tulsa, Oklahoma

STATE OF OKLAHOMA COUNTY OF TULSA, ss.  
Dan W. Brown/Thoroughbred Drilling Company (employee of owner) or (owner or operator) of the above-described well, being first duly sworn on oath, says: That I have knowledge of the facts, statements, and matters herein contained and the log of the above-described well as filed and that the same are true and correct. So help me God.

(Signature) Dan W. Brown  
517 Ritz Building, Tulsa, Oklahoma  
(Address)

SUBSCRIBED AND SWORN to before me this 11th day of April, 19 66

My commission expires February 21, 1969  
Maxine D. Provine Notary Public.

15-167-30132-00-00



drilling company • tulsa

517 RITZ BUILDING TELEPHONE LU 2-1181

DRILLER'S LOG

L. J. Witt #1  
NW/4 NE/4 NE/4 Sec. 10-14S-12W  
Russell County, Kansas

National Associated Petroleum Co.  
Thoroughbred Drilling Co.

0'	-	318'	Rock & Shale
318'	-	1180'	Red Bed, Shale, Shells
1180'	-	1750'	Sand Lime & Shale
1750'	-	1850'	Lime
1850'	-	2755'	Shale & Lime
2755'	-	3335'	Lime
3335'	-	3418'	Sandy Lime

THOROUGHBRED DRILLING CO.

Daniel W. Brown

RECEIVED  

APR 13 1966

CONSERVATION DIVISION  
