


STATE OF KANSAS  
STATE CORPORATION COMMISSION

Give All Information Completely  
Make Required Affidavit  
Mail or Deliver Report to:  
Conservation Division  
State Corporation Commission  
211 No. Broadway  
Wichita, Kansas

15-167-04329-00-00  
WELL PLUGGING RECORD

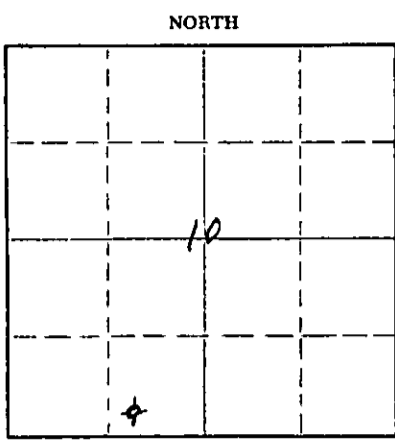

Locate well correctly on above Section Plat

Russell County, Sec. 10 Twp. 14 Rge. (E) 12 (W)  
Location as "NE/CNW/SW" or footage from lines SW SE SW  
Lease Owner Thos. H. Allan, et al  
Lease Name Bohnen Well No. 1  
Office Address 925 Union Center, Wichita 2, Kansas  
Character of Well (completed as Oil, Gas or Dry Hole) Dry Hole  
Date well completed June 13 1959  
Application for plugging filed June 13 1959  
Application for plugging approved June 13 1959  
Plugging commenced June 14 1959  
Plugging completed June 14 1959  
Reason for abandonment of well or producing formation Dry Hole

If a producing well is abandoned, date of last production 19  
Was permission obtained from the Conservation Division or its agents before plugging was commenced? Yes

Name of Conservation Agent who supervised plugging of this well Don Truan  
Producing formation Arbuckle Depth to top 3293 Bottom - - - - Total Depth of Well 3314 Feet  
Show depth and thickness of all water, oil and gas formations.

OIL, GAS OR WATER RECORDS

CASING RECORD

FORMATION	CONTENT	FROM	TO	SIZE	PUT IN	PULLED OUT
				8 5/8"	470'	None

Describe in detail the manner in which the well was plugged, indicating where the mud fluid was placed and the method or methods used in introducing it into the hole. If cement or other plugs were used, state the character of same and depth placed, from feet to feet for each plug set.

3314 - 350 Mud  
350 - 275 Bridge of 1/4 sack hulls, rock, Howco plug, & 25 sacks of cement  
275 - 40 Mud  
40 - Surface Bridge of 1/4 sack hulls, rock, Howco plug, & 10 sacks of cement

RECEIVED  
STATE CORPORATION COMMISSION  
JUN 20 1959  
CONSERVATION DIVISION  
06-20-1959

(If additional description is necessary, use BACK of this sheet)  
Name of Plugging Contractor Thos. H. Allan  
Address 925 Union Center, Wichita 2, Kansas

STATE OF KANSAS, COUNTY OF SEDGWICK, ss.  
Thos. H. Allan (employee of owner) or (owner or operator) of the above-described well, being first duly sworn on oath, says: That I have knowledge of the facts, statements, and matters herein contained and the log of the above-described well as filed and that the same are true and correct. So help me God.

(Signature) Thos. H. Allan  
925 Union Center, Wichita 2, Kansas  
(Address)

SUBSCRIBED AND SWORN TO before me this 16th day of June, 1959  
Ocie M. Stewart  
Notary Public.

My commission expires June 14, 1962

PLUGGING  
FILE SEC 10. T. 14. R. 24  
BOOK PAGE 47 LINE 14

8 5/8" @ 470' - 175 Sx Circ.

15-167-04329-00-00

ALLAN, et al - #1 BOHNEN  
SW SE SW 10-14-12W  
Russell County, Kansas  
COMM: 6/3/59 COMPL: 6/14/59  
CONTRACTOR: Tom Allan  
ELEVATION: 1812 RB

I.P. D & A

All Depths From Rotary Bushings

- 0 - 15 Soil
- 50 Lime Rock
- 160 Blue Shale
- 225 Gray Shale & Sandstone
- 360 Red & Gray Shale
- 446 Sandy Shale
- 450 Sandstone
- 470 Red Beds
- 690 Red Shale
- 726 Anhydrite
- 950 Red Shale
- 1050 Shale
- 1300 Salt & Shale
- 1500 Shale & Anhydrite
- 1800 Lime & Shale Streaks
- 2550 Shale & Shells
- 2800 Lime
- 2820 Porous Lime
- 2845 Lime
- 2848 Black Shale
- 2852 Hard Buff Lime
- 2863 Shale
- 2879 White Lime, Little Oil Saturation
- 2890 Shale
- 2901 Sandstone & Grit
- 2928 Shale
- 2936 Lime
- 2940 Oolitic Lime
- 2960 Lime
- 2978 Oolitic Lime
- 3014 Lime
- 3019 Shale
- 3025 Cherty Lime
- 3040 Soft Oolitic Lime,  
Show of Oil in Top
- 3045 Hard Lime
- 3050 Oolitic Lime
- 3065 Lime
- 3070 Shale
- 3111 Lime
- 3126 Soft Porous Lime
- 3145 Hard Lime
- 3158 Soft Shale & Lime
- 3190 Lime
- 3193 Cherty Lime
- 3210 Lime
- 3247 Red & Gray Shale
- 3250 Lime

- 3268 Shale
- 3290 Varicolor Cherts in Red Mud
- 3293 Red & Green Shale
- 3314 (T.D.) Dolomite & Chert

D.S.T. 2865-2931  
Gas in 30 min., 50 ft. Rotary Mud  
B.H.P. 1010#

FORMATION TOPS:

- |              |                   |
|--------------|-------------------|
| 690 (+1122)  | Anhydrite         |
| 2845 (-1033) | Heebner           |
| 2928 (-1116) | Lansing           |
| 3268 (-1456) | Sooy Conglomerate |
| 3293 (-1481) | Arbuckle          |

I certify that this is a true and correct copy of the well log.

Tom Allan

Subscribed and sworn to before me this 19th day of June, 1959.

Oliver M. Stewart  
Notary Public

My commission expires June 14, 1962.

RECEIVED  
STATE OF KANSAS  
JUN 20 1959  
CONSERVATION DIVISION  
Wichita, Kansas  
06-30-1959

PLUGGING  
FILE SEG. 10 T. 14 R. 12E  
BOOK PAGE 47 LINE 12