

15-167-20248-00-00

STATE OF KANSAS  
STATE CORPORATION COMMISSION


Form CP-4

WELL PLUGGING RECORD

Give All Information Completely  
Make Required Affidavit  
Mail or Deliver Report to:  
Conservation Division  
State Corporation Commission  
212 No. Market  
Wichita, Kansas

Russell County, Sec. 25 Twp. 14 Rge. (E) 11 (W)

Location as "NE/CNW/SW" or footage from lines NE NE NW  
Lease Owner Will P. Ash  
Lease Name Beisel Well No. 1  
Office Address 507 Rutland Road, Wichita, Kansas  
Character of Well (completed as Oil, Gas or Dry Hole) dry hole  
Date well completed 12-4-68 19  
Application for plugging filed 12-4-68 19  
Application for plugging approved 12-4-68 19  
Plugging commenced 12-4-68 19  
Plugging completed 12-4-68 19  
Reason for abandonment of well or producing formation Dry hole

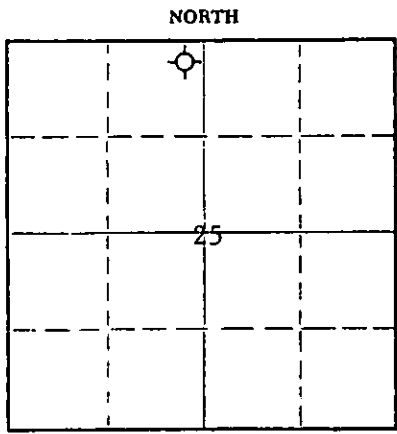

Locate well correctly on above Section Plat

If a producing well is abandoned, date of last production 19  
Was permission obtained from the Conservation Division or its agents before plugging was commenced? Yes

Name of Conservation Agent who supervised plugging of this well Don Truane  
Producing formation \_\_\_\_\_ Depth to top \_\_\_\_\_ Bottom \_\_\_\_\_ Total Depth of Well 2879 Feet  
Show depth and thickness of all water, oil and gas formations.

OIL, GAS OR WATER RECORDS				CASING RECORD		
FORMATION	CONTENT	FROM	TO	SIZE	PUT IN	PULLED OUT

Describe in detail the manner in which the well was plugged, indicating where the mud fluid was placed and the method or methods used in introducing it into the hole. If cement or other plugs were used, state the character of same and depth placed, from \_\_\_\_\_ feet to \_\_\_\_\_ feet for each plug set.

Filled hole to 270 feet with heavy mud. Set plug and 1/4 sack rolled tied hulls at 270 feet. Cemented hole with 40 sacks through drill pipe. Filled hole to 40 feet with heavy mud. Dumped 1/2 sacks hulls on fluid at 40 feet. Dumped 1/2 sack dry cement on hulls. Pushed 1/4 sack hulls rolled and tied on top of bridge. Cemented top of hole with 10 sacks cement. Bridge rat hole and cemented with two sacks cement three feet below ground level.

RECEIVED  
STATE CORPORATION COMMISSION  
JAN 14 1969  
CONSERVATION DIVISION  
Wichita, Kansas

(If additional description is necessary, use BACK of this sheet)  
Name of Plugging Contractor American Drilling Co., Ltd.  
Address 550 Sutton Place, Wichita, Kansas

STATE OF Kansas COUNTY OF Sedgwick ss.  
Larry G. Stephenson (employee of owner) or (owner or operator) of the above-described well, being first duly sworn on oath, says: That I have knowledge of the facts, statements, and matters herein contained and the log of the above-described well as filed and that the same are true and correct. So help me God.

(Signature) Larry G. Stephenson  
550 Sutton Place, Wichita, Kansas  
(Address)

SUBSCRIBED AND SWORN TO before me this 7th day of January, 1969

Marjorie Stephenson  
Notary Public.

My commission expires My Commission Expires July 25, 1972

COMPANY: Will P. Ash  
 CONTRACTOR: American Drilling Co., Ltd.  
 FARM: Beisel #1  
 LOCATION: Section 25-14-11W, Russell County  
 NE NE NW  
 COMMENCED: November 26, 1968  
 COMPLETED: December 4, 1968

---

0	to	283	Shale
283	to	409	Iron & Sand
409	to	527	Red Bed
527	to	546	Anhydrite
546	to	895	Shale
895	to	2400	Lime & Shale
2400	to	2879	Lime
		2879	Total Depth

---

Set 277 feet of 8 5/8" surface pipe w/ 225 sacks common cement

Dry and Abandoned

---

CERTIFICATE

I, Larry G. Stephenson, do hereby certify that the above and foregoing is a true and correct copy of the drillers log of the Beisel #1, Section 25-14-11W, Russell County, Kansas as reflected by files of the American Drilling Co., Ltd.

  
 Larry G. Stephenson

RECEIVED  
 STATE CORPORATION COMMISSION  
 JAN 14 1969  
 CONSERVATION DIVISION  
 Wichita, Kansas