

STATE OF KANSAS  
STATE CORPORATION COMMISSION


Form CP-4

Give All info on Completely  
Make Required Affidavit  
Mail or Deliver Report to:  
Conservation Division  
State Corporation Commission  
212 No. Market  
Wichita, Kansas 67202

WELL PLUGGING RECORD

Russell County, Sec. E 22 Twp. 14 Rge. 11 (E) (W)

Location as "NE/CNW/SW" or footage from lines SE SE EE  
Lease Owner Salina Basing Oil Co.  
Lease Name Brown #1 Well No. \_\_\_\_\_  
Office Address Salina, Kansas 67401  
Character of Well (completed as Oil, Gas or Dry Hole) \_\_\_\_\_  
Date well completed \_\_\_\_\_ 19\_\_\_\_  
Application for plugging filed \_\_\_\_\_ 19\_\_\_\_  
Application for plugging approved \_\_\_\_\_ 19\_\_\_\_  
Plugging commenced 2/1/71 \_\_\_\_\_ 19\_\_\_\_  
Plugging completed 4/6/71 \_\_\_\_\_ 19\_\_\_\_  
Reason for abandonment of well or producing formation depleted.

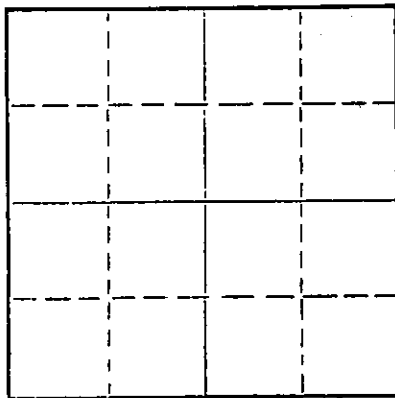

Locate well correctly on above  
Section Plat

If a producing well is abandoned, date of last production \_\_\_\_\_ 19\_\_\_\_  
Was permission obtained from the Conservation Division or its agents before plugging was com-  
menced? YGE

Name of Conservation Agent who supervised plugging of this well Truett  
Producing formation \_\_\_\_\_ Depth to top \_\_\_\_\_ Bottom \_\_\_\_\_ Total Depth of Well 2800' Feet  
Show depth and thickness of all water, oil and gas formations.

OIL, GAS OR WATER RECORDS

CASING RECORD

FORMATION	CONTENT	FROM	TO	SIZE	PUT IN	PULLED OUT
				8-5/8	282	none
				5 1/2"	2255'	1827'

Describe in detail the manner in which the well was plugged, indicating where the mud fluid was placed and the method or methods used in introducing it into the hole. If cement or other plugs were used, state the character of same and depth placed, from \_\_\_\_\_ feet to \_\_\_\_\_ feet for each plug set.

Checked hole to 2204', ran sand to 2150' and dumped 5 sacks of cement.  
Shot pipe at 2017', 1921', 1827', worked pipe loose and pulled 58 joints.  
Allied pumped 2 sacks hulls, 20 sacks mud, 1 sack hulls and 90 sacks of  
cement.

PLUGGING COMPLETE.

RECEIVED  
STATE CORPORATION COMMISSION  
APR 16 1971  
CONSERVATION DIVISION  
Wichita, Kansas

Name of Plugging Contractor KNIGHT CASING PULLING CO., I.C.  
Address CHASE, KANSAS

STATE OF KANSAS, COUNTY OF RICE, ss.  
NOEL J. KNIGHT (employee of owner) or (owner or operator) of the above-described well, being first duly sworn on oath, says: That I have knowledge of the facts, statements, and matters herein contained and the log of the above-described well as filed and that the same are true and correct. So help me God.

(Signature) [Signature]  
CHASE, KANSAS  
(Address)

SUBSCRIBED AND SWORN to before me this 7th day of April, 19 71

My commission expires 2/15/75

[Signature]  
Notary Public.