


15-051-21220-0000

FORM CP-4

STATE OF KANSAS  
STATE CORPORATION COMMISSION  
CONSERVATION DIVISION  
P. O. BOX 17027  
WICHITA, KANSAS 67217

15-051-21220-00-00  
WELL PLUGGING RECORD

Ellis County, Sec. 8 Twp. 11 Rge. 18 (E) W (W)  
Location as "NE/CNW/SE" or footage from lines Center W 1/2

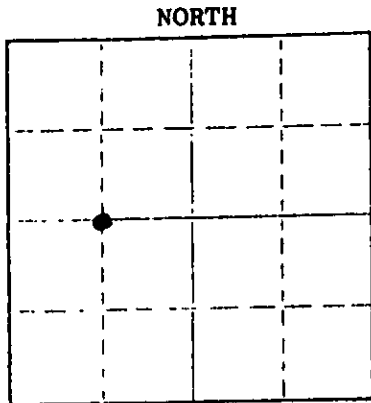

Locate well correctly on above Section Plat

Lease Owner Robert R. Price  
Lease Name Cave Well No. #8  
Office Address Box 45442/Tulsa, OK 74145  
Character of Well (completed as Oil, Gas or Dry Hole) Dry Hole  
Date well completed 10-18 19 76  
Application for plugging filed 10-18 19 76  
Application for plugging approved 10-18 19 76  
Plugging commenced 10-18 19 76  
Plugging completed 10-18 19 76  
Reason for abandonment of well or producing formation Dry Hole

If a producing well is abandoned, date of last production ----- 19 \_\_\_\_  
Was permission obtained from the Conservation Division or its agents before plugging was commenced? Yes.

Name of Conservation Agent who supervised plugging of this well Leo Massey  
Producing formation ----- Depth to top ----- Bottom ----- Total Depth of Well 3554' Feet  
Show depth and thickness of all water, oil and gas formations.

OIL, GAS OR WATER RECORDS

CASING RECORD

FORMATION	CONTENT	FROM	TO	SIZE	PUT IN	PULLED OUT
				8 5/8"	265'	NONE

Describe in detail the manner in which the well was plugged, indicating where the mud fluid was placed and the method or methods used in introducing it into the hole. If cement or other plugs were used, state the character of same and depth placed, from \_\_\_\_\_ feet to \_\_\_\_\_ feet for each plug set.

Plug with 50 sacks 50/50 Pozmix @ 550'  
25 sacks @ 240'  
10 sacks & Bridge & Plug @ 40'  
Job completed @ 9:00 P.M. by Sun Cementing

11-05-76

(If additional description is necessary, use BACK of this sheet)  
Name of Plugging Contractor Allen Drilling Company  
Address P.O. Box 1389/Great Bend, KS 67530

STATE OF Kansas COUNTY OF Barton, ss.  
Allen Drilling Company (employee of owner) or (owner or operator) of the above-described well, being first duly sworn on oath, says: That I have knowledge of the facts, statements, and matters herein contained and the log of the above-described well as filed and that the same are true and correct. So help me God.

(Signature) Glenn C. Bishop  
P.O. Box 1389/Great Bend, KS 67530  
(Address)

SUBSCRIBED AND SWORN TO before me this 19th day of October 19 76

My commission expires 11-25-79

LaVelta M. Murnahan  
Notary Public.



KANSAS DRILLERS LOG

S. 8 T. 11 R. 18 <sup>E</sup><sub>W</sub>

Loc. C W2

County Ellis

API No. 15 — 051 — 21,220-0000  
County Number

Operator  
Robert R. Price

Address  
Box 45442 Tulsa, Oklahoma 74145

Well No. #8 Lease Name Cave


Footage Location  
2640 feet from (N) line 1320 feet from (W) line

Principal Contractor Allen Drilling Co. Geologist Robert R. Price

Spud Date 10-11-76 Total Depth 3554 P.B.T.D.

Date Completed 10-18-76 Oil Purchaser

640 Acres  
N

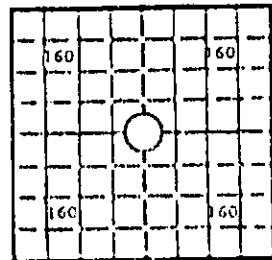

Locate well correctly

Elev.: Gr. 1951

DF 1954 KB 1957

CASING RECORD

Report of all strings set— surface, intermediate, production, etc.

Purpose of string	Size hole drilled	Size casing set (in O.D.)	Weight lbs/ft.	Setting depth	Type cement	Sacks	Type and percent additives
<u>Surface</u>	<u>12 1/4"</u>	<u>8 5/8"</u>	<u>24</u>	<u>265'</u>	<u>Commer</u>	<u>175</u>	<u>2% Gel 3% CaCl</u>

LINER RECORD

PERFORATION RECORD

Top, ft.	Bottom, ft.	Sacks cement	Shots per ft.	Size & type	Depth interval

TUBING RECORD

Size	Setting depth	Packer set at

ACID, FRACTURE, SHOT, CEMENT SQUEEZE RECORD

Amount and kind of material used	Depth interval treated

INITIAL PRODUCTION

Date of first production	Producing method (flowing, pumping, jet lift, etc.)		
RATE OF PRODUCTION PER 24 HOURS	Oil bbls.	Gas bbls.	Water MCF
Disposition of gas (vented, used on lease or sold)	Gas-oil ratio		CFPB
Producing interval(s)			

INSTRUCTIONS: As provided in KCC Rule 82-2-125, within 90 days after completion of a well, one completed copy of this Drillers Log shall be transmitted to the State Geological Survey of Kansas, 4150 Monroe Street, Wichita, Kansas 67209. Copies of this form are available from the Conservation Division, State Corporation Commission, 3830 So. Meridian (P.O. Box 17027), Wichita, Kansas 66217. Phone AC 316-522-2206. If confidential custody is desired, please note Rule 82-2-125. Drillers Logs will be on an open file in the Oil and Gas Division, State Geological Survey of Kansas, Lawrence, Kansas 66044.

RECEIVED  
STATE CORPORATION COMMISSION  
DEC 23 1976  
CONSERVATION DIVISION  
Wichita, Kansas

Operator

Robert R. Price

DESIGNATE TYPE OF COMP.: OIL, GAS, DRY HOLE, SWDW, ETC.:

Well No.

8

Lease Name

Cave 15.051.71220.00.00

Dry Hole

S 8 T 11S R 18 W

WELL LOG

Show all important zones of porosity and contents thereof; cored intervals, and all drill-stem tests, including depth interval tested, cushion used, time tool open, flowing and shut-in pressures, and recoveries.

SHOW GEOLOGICAL MARKERS, LOGS RUN, OR OTHER DESCRIPTIVE INFORMATION.

FORMATION DESCRIPTION, CONTENTS, ETC.	TOP	BOTTOM	NAME	DEPTH
DST #1 3160-3235			Anhydrite	1276
ISIP 948			Topeka	2949
FSIP 520			Heebner	3166
Open hr. Recovered			Lansing	3206
125' OSM			B/KC	3433
DST #2 3330-3440			Conglomerate	3470
ISIP 969			TD	3554
FSIP 877				
Open 30" Recovered				
80' OSM				

RECEIVED  
 STATE CORPORATION COMMISSION  
 DEC 23 1976  
 CONSERVATION DIVISION  
 Wichita, Kansas

USE ADDITIONAL SHEETS, IF NECESSARY, TO COMPLETE WELL RECORD.

Date Received

*Robert R. Price*

Signature

Title

Date