


STATE OF KANSAS
STATE CORPORATION COMMISSION

15-051-01744-00-00
WELL PLUGGING RECORD

Give All Information Completely
Make Required Affidavit
Mail or Deliver Report to:
Conservation Division
State Corporation Commission
800 Bitting Building
Wichita, Kansas

Ellis County, Sec. 8 Twp. 11 Rge. 18 (S) (W)

NORTH

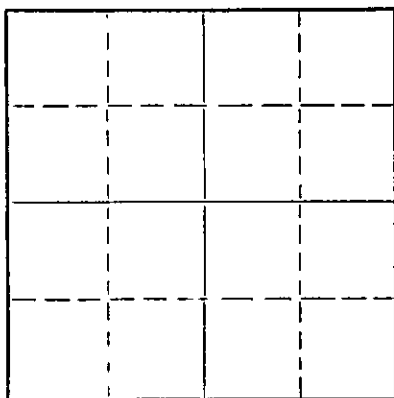

Locate well correctly on above Section Plat

Location as "NE/CNW/SW" or footage from lines NW NW SE
Lease Owner National Cooperative Refinery Association
Lease Name Cave Well No. 2
Office Address 820 Union National Bank Building
Character of Well (completed as Oil, Gas or Dry Hole) Dry Hole
Date well completed December 16, 19 52
Application for plugging filed December 16, 19 52
Application for plugging approved December 17, 19 52
Plugging commenced December 17, 19 52
Plugging completed December 17, 19 52
Reason for abandonment of well or producing formation Non Productive

If a producing well is abandoned, date of last production 19
Was permission obtained from the Conservation Division or its agents before plugging was commenced? Yes

Name of Conservation Agent who supervised plugging of this well Eldon Petty
Producing formation _____ Depth to top _____ Bottom _____ Total Depth of Well _____ Feet
Show depth and thickness of all water, oil and gas formations.

OIL, GAS OR WATER RECORDS

CASING RECORD

FORMATION	CONTENT	FROM	TO	SIZE	PUT IN	PULLED OUT
				8 5/8"	22 1/2'	Cemented

Describe in detail the manner in which the well was plugged, indicating where the mud fluid was placed and the method or methods used in introducing it into the hole. If cement or other plugs were used, state the character of same and depth placed, from _____ feet to _____ feet for each plug set.

Filled hole with heavy mud from 3705' to 210', set plug, dumped 15 sacks cement thru drill pipe, mudded hole to 40', set plug 1/2 sacks hulls on top of plug, dumped 10 sacks cement on up to base of cellar.

(If additional description is necessary, use BACK of this sheet)

Name of Plugging Contractor Glenn R. Nye Drilling Company
Address Box 30, Hays, Kansas.

STATE OF Kansas, COUNTY OF Sedgwick, ss.
W. Jean La Coss (employee of owner) or (~~owner or operator~~) of the above-described well, being first duly sworn on oath, says: That I have knowledge of the facts, statements, and matters herein contained and the log of the above-described well as filed and that the same are true and correct. So help me God.

(Signature) W. Jean La Coss
820 Union National Bank Building
(Address)

SUBSCRIBED AND SWORN TO before me this 19 day of December, 19 52

My commission expires February 20, 1953 I. A. Lange Notary Public.

24-2675-5 2-52-20M

PLUGGING
FILE SEC 8 T 11 R 18 W
BOOK PAGE 66 LINE 16

12-20-52

Company: National Cooperative Refinery Ass'n
 Contractor: Glenn R. Nye Drilling Company
 Commenced: December 1, 1952
 Completed: December 16, 1952

Farm: Cave #2
 Location: NW NW SE Sec. 8-11-18
 Ellis County, Kansas
 Casing Record: 8 5/8" set at 224'

15-051-04744-00-00

(Figures below indicate bottoms)

yellow clay	30
blue shale	224
blue shale	470
sand & shale	525
sand & shale	798
sand	991
sand & shale	1045
red bed, shale & sand	1295
anhydrite	1334
shale & shells	1445
shale	1835
shale & shells	2025
shale & lime	2135
lime & shale	2255
lime & shale	2410
shale & lime	2540
shale & lime	2645
shale & lime	2740
shale & lime	2865
shale & lime	2990
shale & lime	3065
lime & shale	3135
lime & shale	3185
lime & shale	3206
lime & shale	3207
lime & shale	3220
lime & shale	3240
lime & shale	3253 Top of K.C. 3256'
lime	3284
lime	3302
lime	3330
lime & shale	3375
lime	3400
lime	3415
lime	3430
lime	3455
lime & shale	3495 Cong 3523'
lime & shale	3570
cong.	3586 Simpson 3614'
cherty	3618
cherty cong.	3641
cherty cong.	3685 Top of arbuckle 3657'
arbuckle	3706

I hereby certify that this is a true and correct log of the above described well as shown by the drilling reports.

GLENN R. NYE DRILLING COMPANY

By Claude N. Bark

STATE OF KANSAS)
) SS
 ELLIS COUNTY)

Subscribed and sworn to before me, a Notary Public, in and for said County and State this 24th day of Dec., 1952.

John L. Spies
 Notary Public

My Commission Expires, May 9, 1953

PLUGGING
 FILE SEC 274-R-114
 BOOK PAGE 46 LINE 16

CONSERVATION
 VICTOR
 Kansas