


15-167-00163-00-00

STATE OF KANSAS
STATE CORPORATION COMMISSION

Give All Information Completely
Make Required Affidavit
Mail or Deliver Report to:
Conservation Division
State Corporation Commission
800 Biting Building
Wichita, Kansas

WELL PLUGGING RECORD

NORTH

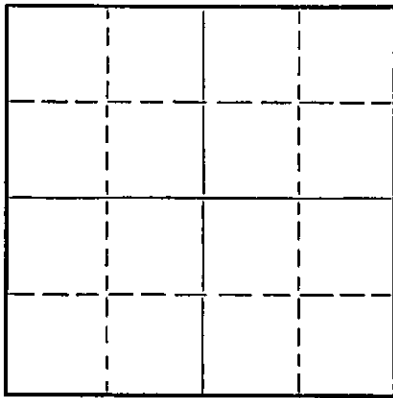

Locate well correctly on above
Section Flat

Russell County. Sec. 27 Twp. 14 Rge. 12 (E) W (W)
Location as "NE/CNW $\frac{1}{4}$ SW $\frac{1}{4}$ " or footage from lines SW NW SE
Lease Owner Duke & Wood Drilling Co., Inc.
Lease Name Hampl Well No. 1
Office Address Box 194, Great Bend, Kansas
Character of Well (completed as Oil, Gas or Dry Hole) Dry Hole
Date well completed April 1 19 51
Application for plugging filed April 1 19 51
Application for plugging approved April 1 19 51
Plugging commenced April 2 19 51
Plugging completed April 2 19 51
Reason for abandonment of well or producing formation Dry Hole

If a producing well is abandoned, date of last production 19
Was permission obtained from the Conservation Division or its agents before plugging was commenced? Yes

Name of Conservation Agent who supervised plugging of this well Eldon Petty
Producing formation Depth to top Bottom Total Depth of Well 3177' Feet
Show depth and thickness of all water, oil and gas formations.

OIL, GAS OR WATER RECORDS

CASING RECORD

Formation	Content	From	To	Size	Put In	Pulled Out
				8 5/8"	160'	None

Describe in detail the manner in which the well was plugged, indicating where the mud fluid was placed and the method or methods used in introducing it into the hole. If cement or other plugs were used, state the character of same and depth placed, from feet to feet for each plug set.

Filled hole with heavy mud to 150', set wooden plug, dumped 15 sacks cement thru drill pipe. Filled hole with heavy mud to 40', set plug on steel line, one half sack hulls and 10 sacks of cement on same.

04-19-1951

(If additional description is necessary, use BACK of this sheet)

Correspondence regarding this well should be addressed to Duke & Wood Drilling Co., Inc.
Address Box 194, Great Bend, Kansas

STATE OF Kansas, COUNTY OF Barton, ss.
Cecil M. Olson (employee of owner) of the above-described well, being first duly sworn on oath, says: That I have knowledge of the facts, statements, and matters herein contained and the log of the above-described well as filed and that the same are true and correct. So help me God.

(Signature) C Olson
Great Bend, Kansas (Address)

SUBSCRIBED AND SWORN to before me this 10th day of April, 19 51

Dean E. Hooley (Notary Public)

My commission expires April 29, 1953.

23-5091-s 8-50-10M

FILE SEC 27 T 14 R 12
BOOK PAGE 71 LINE 31

15-167-00163-00-00

WELL LOG
Hamp #1
SW NW SE Sed. 27-14-12W
Russell County, Kansas

Started: March 22, 1951
Completed: April 2, 1951

Elevation 1661' R. B.
Anhydrite 567' (/ 1094)
Heebner 2730' (-1069)
Lansing 2818' (-1157)
Conglomerate - 3130' (-1469)
Arbuckle 3154' (-1493)

0-160	Clay, sand and red rock
160-567	Red bed, shale, sand, shells
567-599	Anhydrite
599-930	Red bed, shale and shells
930-1300	Shale, shells and salt
1300-1440	Shale, shells and lime
1440-1650	Lime and shale
1650-1740	Lime and shale
1740-1965	Lime and shale
1965-2090	Lime and shale
2090-2395	Lime and shale
2395-2460	Lime and shale
2460-2540	Lime
2540-2665	Lime
2665-2800	Lime and shale
2800-2952	Lime
2952-3080	Lime
3080-3130	Lime
3130-3154	Conglomerate
3154-3177	Lime
3177	TOTAL ROTARY DEPTH

A F F I D A V I T

STATE OF Kansas, COUNTY OF Barton, SS

I, Frank G. Wood of the DUKE & WOOD DRILLING Company INC. being first duly sworn on oath, state; That I have knowledge of the facts, statements and matters herein contained and that the same are true and correct.

PLUGGING 04-19-1951
FILE SEC-27T-14-R-1062
BOOK PAGE-76 LINE-31

Frank G. Wood
President

Subscribed and sworn to before me this 18 day of April 1951.

Dean E. Looney
Notary Public

My commission expires: April 29, 1953.