

15-167-21285-00-00


STATE OF KANSAS
STATE CORPORATION COMMISSION

WELL PLUGGING RECORD

Give All Information Completely
Make Required Affidavit
Mail or Deliver Report to
Conservation Division
State Corporation Comm.
245 North Water
Wichita, KS 67202

Russell County, Sec. 25 Twp. 14S Rge. 12 E/W
Location as "NE/CNW $\frac{1}{4}$ SW $\frac{1}{4}$ " or footage from lines
SW SW SE

Lease Owner Ernst & Steidle Operations
Lease Name Herber Well No. 1
Office Address 1025 N. Main, Russell, KS 67665
Character of Well (Completed as Oil, Gas or Dry Hole)

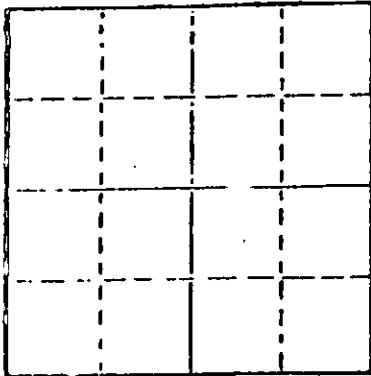

Locate well correctly on above
Section Plot

Date Well completed 2-17 1979
Application for plugging filed 2-17 1979
Application for plugging approved 2-17 1979
Plugging commenced 2-17 1979
Plugging completed 2-18 1979
Reason for abandonment of well or producing formation
Dry Hole

If a producing well is abandoned, date of last production 19

Was permission obtained from the Conservation Division or its agents before plugging was commenced? Yes

Name of Conservation Agent who supervised plugging of this well Duane Rankin
Producing formation Depth to top Bottom Total Depth of Well 3130
Show depth and thickness of all water, oil and gas formations.

OIL, GAS OR WATER RECORDS

CASING RECORD

FORMATION	CONTENT	FROM	TO	SIZE	PUT IN	PULLED OUT
				8-5/8"	235'	-0-

Describe in detail the manner in which the well was plugged, indicating where the mud fluid was placed and the method or methods used in introducing it into the hold. If cement or other plugs were used, state the character of same and depth placed, from feet to feet for each plug set.

Mud laden fluid 420 to 3130'
50 sks cement @ 420'
25 sks cement @ 210'
10 sks cement @ 40'
2 sks cement in rat hole

RECEIVED
STATE CORPORATION COMMISSION
FEB 22 1979
02-22-1979
CONSERVATION DIVISION
Wichita, Kansas

(If additional description is necessary, use BACK of this sheet)

Name of Plugging Contractor Emphasis Oil Operations

STATE OF KANSAS COUNTY OF RUSSELL, ss.
Joe K. Branum (employee of owner) or (owner or operator)
of the above-described well, being first duly sworn on oath, says: That I have knowledge of the facts, statements, and matters herein contained and the log of the above-described well as filed and that the same are true and correct. So help me God.


(Signature)

Joe K. Branum
Box 506, Russell, KS 67665
(Address)

SUBSCRIBED AND SWORN TO before me this 20th day of February, 1979

Patricia Clark
Notary Public.

My commission expires October 2, 1979

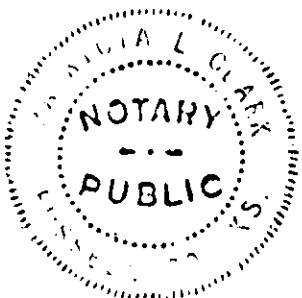

15-167-21285-00-00

EMPHASIS OIL OPERATIONS

P. O. Box 506

Russell, Kansas 67665

DRILLERS LOG

OPERATOR: Ernst & Steinle Operations 1025 N. Main Russell, Kansas 67665
CONTRACTOR: Emphasis Oil Operations Box 506 Russell, Kansas 67665

LEASE: Herber WELL: #1 LOCATION: SW SW SE Section 25-14S-12W Russell County, Kansas

Total Depth: 3130' Elevation:
Commenced: 2-10-79 Completed: 2-18-79
Casing: 8-5/8" @ 235' Status: Dry Hole

DEPTHS & FORMATIONS

(All measurements from K.B.)

Shale	241	Lime	2618
Sand & Shale	515	Shale & Lime	2817
Anhydrite	546	Lime & Shale	3030
Shale	1660	Shale & Lime (R.T.D.)	3130
Shale & Lime	2510		

RECEIVED

Kansas

STATE OF KANSAS)
COUNTY OF RUSSELL) ss

I, Joe K. Branum, of Emphasis Oil Operations state that the above and foregoing is a true and correct log of the above captioned well.

Joe K. Branum
Joe K. Branum

Subscribed and sworn to before me this 20th day of February, 1979.
My Commission Expires: October 2, 1979.

Patricia L. Clark
Notary Public

