


STATE OF KANSAS  
STATE CORPORATION COMMISSION

15-051-03839-00-00  
WELL PLUGGING RECORD

Give All Information Completely  
Make Required Affidavit  
Mail or Deliver Report to:  
Conservation Division  
State Corporation Commission  
212 North Market, Insurance Bldg.  
Wichita, Kansas

Ellis County, Sec. 6 Twp. 14 Rge. 16 (W)  
Location as "NE/CNW&SW" or footage from lines approx. SE SE SE  
Lease Owner Rudy Herman Oil Operations  
Lease Name Dreiling Well No. 1  
Office Address Box 348 Russell, Kansas  
Character of Well (completed as Oil, Gas or Dry Hole) dry hole  
Date well completed July 30 19 60  
Application for plugging filed July 30 19 60  
Application for plugging approved no date on "Well Plugging Authority"  
Plugging commenced 2:50 p.m. July 30 19 60  
Plugging completed 8:30 p.m. " " 19 60  
Reason for abandonment of well or producing formation dry hole

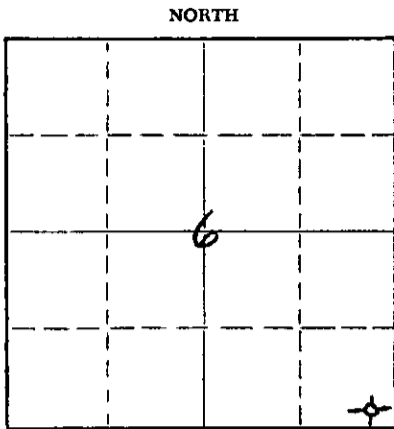

Locate well correctly on above Section Plat

If a producing well is abandoned, date of last production 19  
Was permission obtained from the Conservation Division or its agents before plugging was commenced? yes

Name of Conservation Agent who supervised plugging of this well Mr. Eldon Petty  
Producing formation \_\_\_\_\_ Depth to top \_\_\_\_\_ Bottom \_\_\_\_\_ Total Depth of Well 3515' Feet  
Show depth and thickness of all water, oil and gas formations.

OIL, GAS OR WATER RECORDS

CASING RECORD

FORMATION	CONTENT	FROM	TO	SIZE	PUT IN	PULLED OUT
				8 5/8"	186'	none

Describe in detail the manner in which the well was plugged, indicating where the mud fluid was placed and the method or methods used in introducing it into the hole. If cement or other plugs were used, state the character of same and depth placed, from \_\_\_\_\_ feet to \_\_\_\_\_ feet for each plug set.

Bottom plug set at 450' with 20 sacks of cement, middle plug at 180' with 1/2 sack of hulls and 20 sacks of cement, top plug at 30' with 1/2 sack of hulls and 10 sacks of cement.

RECEIVED  
CORPORATION COMMISSION

AUG 10 1960

CONSERVATION DIVISION  
KANSAS

(If additional description is necessary, use BACK of this sheet)

Name of Plugging Contractor Triangle Drilling, Inc.  
Address Box 519 Great Bend, Kansas

STATE OF Kansas, COUNTY OF Barton, ss.  
Donald D. Vaughan (employee of owner) or (owner or operator) of the above-described well, being first duly sworn on oath, says: That I have knowledge of the facts, statements, and matters herein contained and the log of the above-described well as filed and that the same are true and correct. So help me God.

(Signature) Donald D. Vaughan  
Box 619 Great Bend, Kansas  
(Address)

SUBSCRIBED AND SWORN TO before me this 5th day of August, 19 60

My commission expires July 1, 1964  
Jessie Lee Dunn Notary Public.



15-051-03839-00-00  
WELL LOG

COMPANY Rudy Herman Oil Operations  
 CONTRACTOR Triangle Drilling, Inc.  
 FARM #1 Dreiling  
 LOCATION Approx. SE SE SE of 6-14-16W  
 Ellis County, Kansas  
 ELEVATION 1956 KB  
 SURFACE PIPE 8 5/8" cemented @ 186° with 145 sacks HA5 cement.  
 PRODUCTION D & A  
 COMMENCED July 20, 1960  
 COMPLETED July 30, 1960

<u>FORMATION</u>	<u>DEPTH</u>
Surface clay and sand	35
Shale	280
Sand	305
Shale	390
Sand	440
Shale	503
Hard sand	515
Blue shale	560
Sand	725
Red bed	1069
Anhydrite	1116
Shale and shells	1930
Lime and shale	2105
Limestone	2400
Lime and shale	2525
Limestone	2643
Lime and shale	2954
Limestone	3467
Dolomite	3515

FORMATION TOPS

Anhydrite	1069 ( / 887)
Topeka	2954 (- 998)
Heebner	3177 (-1221)
Toronto	3197 (-1241)
Lansing	3221 (-1265)
Arbuckle	3467 (-1511)
RTD	3515 (-1559)


A F F I D A V I T

STATE OF KANSAS, COUNTY OF BARTON, SS.

I, Donald D. Vaughan, Petroleum Geologist, being first duly sworn on oath state; That I have knowledge of the facts, statements and matters herein contained and that the same are true and correct.

*Donald D. Vaughan*  
 Donald D. Vaughan

Subscribed and sworn to before me this 6th day of August, 1960.

*Donna Lea Foelgner*  
 Donna Lea Foelgner  
 Notary Public

My commission expires: May 11, 1963.