15-167-30186-00-00

STATE OF KANSAS
STATE CORPORATION COMMISSION

Give All Information Completely
Make Required Affidavit
Mail or Deliver Report to:
Conservation Division
State Corporation Commission
211 No. Broadway
Wichita, Kansas

Form CP-4

WELL PLUGGING RECORD

NORTH

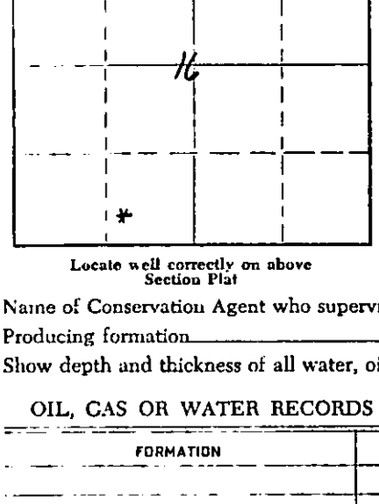

Locate well correctly on above Section Plat

Russell County. Sec. 16 Twp. 14S Rge. (E) 12 (W)

Location as "NE/CNW¼SW¼" or footage from lines SE SE SW

Lease Owner Abercrombie Drilling, Inc.

Lease Name HERBER Well No. 1

Office Address 801 Union Center, Wichita, Ks.

Character of Well (completed as Oil, Gas or Dry Hole) Dry Hole

Date well completed April 4 19 66

Application for plugging filed April 4 19 66

Application for plugging approved April 4 19 66

Plugging commenced April 4 19 66

Plugging completed April 4 19 66

Reason for abandonment of well or producing formation D & A

If a producing well is abandoned, date of last production 19

Was permission obtained from the Conservation Division or its agents before plugging was commenced? Yes - Verbally

Name of Conservation Agent who supervised plugging of this well Mr. Truen

Producing formation Depth to top Bottom Total Depth of Well 3332 Feet

Show depth and thickness of all water, oil and gas formations.

OIL, GAS OR WATER RECORDS

FORMATION	CONTENT	FROM	TO

CASING RECORD

SIZE	PUT IN	PULLED OUT

RECEIVED
STATE CORPORATION COMMISSION
APR 7 1966
04-07-1966
CONSERVATION DIVISION
Wichita, Kansas

Describe in detail the manner in which the well was plugged, indicating where the mud fluid was placed and the method or methods used in introducing it into the hole. If cement or other plugs were used, state the character of same and depth placed, from feet to feet for each plug set.

Plugged hole. Mudded hole to 260 feet. Set plug with 1/4 sack hulls, 25 sacks of cement. Mudded to 40 feet. Set plug with 1/2 sack hulls, 15 sacks of cement. Job completed at 7 a.m., April 4, 1966.

(If additional description is necessary, use BACK of this sheet)

Name of Plugging Contractor Abercrombie Drilling, Inc.

Address 801 Union Center Building, Wichita, Kansas

STATE OF Kansas, COUNTY OF Sedgwick, ss.

Mildred Saxton (employee of owner) or (~~owner or operator~~) of the above-described well, being first duly sworn on oath, says: That I have knowledge of the facts, statements, and matters herein contained and the log of the above-described well as filed and that the same are true and correct. So help me God.

(Signature) Mildred Saxton

801 Union Center, Wichita, Kansas
(Address)

SUBSCRIBED AND SWORN TO before me this 4th day of April, 19 66

Minnie E. Matson
Minnie E. Matson Notary Public.

My commission expires June 18, 1968

15-167-30186-00-00

CONTRACTOR'S WELL LOG

COMPANY:	Abercrombie Drilling, Inc.
CONTRACTOR:	Abercrombie Drilling, Inc.
FARM:	HERBER #1
LOCATION:	SE SE SW Sec. 16-14S-12W Russell County, Kansas
COMMENCED:	March 27, 1966
COMPLETED	April 4, 1966

0	124	Lime & Rock
124	275	Shale & Shells
275	610	Sand & Shale
610	692	Shale
692	723	Anhydrite
723	1380	Shale
1380	1440	Shale & Lime
1440	2077	Lime & Shale
2077	2345	Shale
2345	2973	Lime & Shale
2973	3055	Lime
3055	3332	Lime & Shale
	3332	Total Depth

RECEIVED
STATE CORPORATION COMMISSION
04-07-1966
APR 7 1966
CONSERVATION DIVISION
WICHITA, KANSAS

Set 8-5/8" surface at 269' w/175 sx cement w/3% Calcium chloride

DRY AND ABANDONED

ELEVATION: 1785 K. B.

ELECTRIC LOG TOPS:

Lansing - Kansas City	2921	(-1136)
Arbuckle	3298	(-1513)
Total Depth	3332	(-1547)

STATE OF KANSAS)
) SS
COUNTY OF SEDGWICK)

I, Jack K. Wharton, do hereby certify that the above and foregoing is a true and correct copy of the log of the HERBER #1, SE SE SW, Section 16-14S-12W, Russell County, Kansas, as reflected by the files of Abercrombie Drilling, Inc.

Jack K. Wharton
Jack K. Wharton

Subscribed and sworn to before me, a Notary Public, in and for Sedgwick County, Kansas, this 6th day of April, 1966.

Mildred Saxton
(Mrs) Mildred Saxton

My commission expires October 5, 1968.