

15-167-00460-00-00

STATE OF KANSAS
STATE CORPORATION COMMISSION


Give All Information Completely
Make Required Affidavit
Mail or Deliver Report to:
Conservation Division
State Corporation Commission
212 North Market, Insurance Bldg.
Wichita, Kansas

WELL PLUGGING RECORD

Russell County, Sec. 14 Twp. 14S Rge. (E) 12(W)

Location as "NE/CNW/SW" or footage from lines 1320 fm N line; 710 fm E
Lease Owner Quivira Exploration Company, et al
Lease Name Marie Anschutz Well No. 1
Office Address Box 297, Great Bend, Kansas
Character of Well (completed as Oil, Gas or Dry Hole) Dry Hole
Date well completed April 8 19 60
Application for plugging filed May 7 19 60
Application for plugging approved May 8 19 60
Plugging commenced May 12 19 60
Plugging completed May 12 19 60
Reason for abandonment of well or producing formation Dry

NORTH

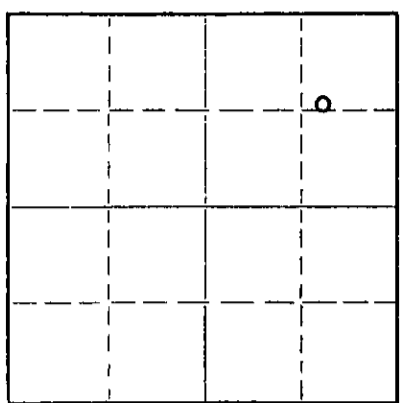

Locate well correctly on above Section Plat

If a producing well is abandoned, date of last production X 19
Was permission obtained from the Conservation Division or its agents before plugging was commenced? Yes

Name of Conservation Agent who supervised plugging of this well Trash
Producing formation X Depth to top X Bottom X Total Depth of Well 1587 Feet
Show depth and thickness of all water, oil and gas formations.


OIL, GAS OR WATER RECORDS

CASING RECORD

FORMATION	CONTENT	FROM	TO	SIZE	PUT IN	PULLED OUT
Fort Riley	Water	1522	1587	7"	60'	None

Describe in detail the manner in which the well was plugged, indicating where the mud fluid was placed and the method or methods used in introducing it into the hole. If cement or other plugs were used, state the character of same and depth placed, from _____ feet to _____ feet for each plug set.

Upper 300 feet plugged solid with cement. Circulated cement into pits.
Cemented by Halliburton. Supervised by L. W. Francis, Great Bend, Kansas.

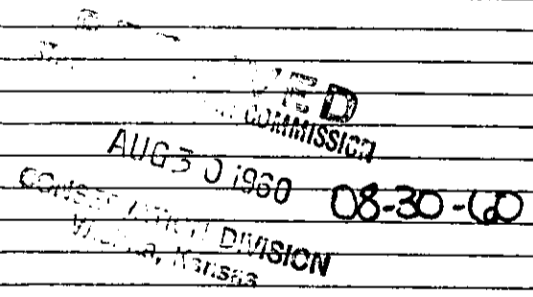

(If additional description is necessary, use BACK of this sheet)
Name of Plugging Contractor Ivan Holt
Address Hoisington, Kansas

STATE OF Kansas, COUNTY OF Barton, ss.
Richard L. Morse (employee of owner) or (owner or operator) of the above-described well, being first duly sworn on oath, says: That I have knowledge of the facts, statements, and matters herein contained and the log of the above-described well as filed and that the same are true and correct. So help me God.

(Signature) Richard L. Morse
Great Bend (Address)

SUBSCRIBED AND SWORN TO before me this 29 day of August, 19 60

My commission expires My Commission Expires Jan. 31, 1962

Notary Public



WELL LOG

Date started January 14, 1960 Date completed January 23, 1960
Name Anschutz #1 Location Sec. 14, 14S, 12W
Company Quivira Exploration Contractor Quivira Exploration
Company, et al
Completion D & A Company
Elevation 1741 KB Casing 7"

Figures indicate bottoms of formations:

Formations

Sand & gravel	40
Sand & shale	300
Lime & shale	695
Lime & shale	840
Shale & sandy lime	980
Lime & shale	1280
Lime	1586
TD	1586

The above information is correct to the best of my knowledge.

Richard L. Morse
Contractor

Subscribed and sworn to before me this

August 8, 1960
Oct 15, 1960

NOTARY PUBLIC

My Commission expires

Oct. 13, 1962

Johnston
RECEIVED
STATE CORPORATION COMMISSION
AUG 30 1960
CONSERVATION DIVISION
Wichita, Kansas