

15-167-00047-00-00


STATE OF KANSAS
STATE CORPORATION COMMISSION

WELL PLUGGING RECORD

Give All Information Completely
Make Required Affidavit
Mail or Deliver Report to:
Conservation Division
State Corporation Commission
800 Bittling Building
Wichita, Kansas

Russell County, Sec. 14 Twp. 14 Rge. 12 (E) W (W)

NORTH

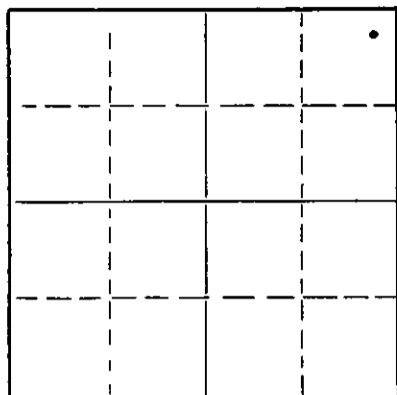

Locate well correctly on above
Section Plat

Location as "NE/CNW/SW" or footage from lines. NE NE NE
Lease Owner Advance Drilling Company
Lease Name Anschutz Well No. 1
Office Address Box 44 Russell, Kansas
Character of Well (completed as Oil, Gas or Dry Hole) Dry Hole
Date well completed October 3 19 53
Application for plugging filed October 7, 19 53
Application for plugging approved October 7, 19 53
Plugging commenced October 2, 19 53
Plugging completed October 3, 19 53
Reason for abandonment of well or producing formation Dry Hole

If a producing well is abandoned, date of last production _____ 19____
Was permission obtained from the Conservation Division or its agents before plugging was commenced? Yes

Name of Conservation Agent who supervised plugging of this well C. D. Stough
Producing formation Tarkio Depth to top 2232 Bottom 2290 Total Depth of Well 2290 Feet
Show depth and thickness of all water, oil and gas formations.

OIL, GAS OR WATER RECORDS

CASING RECORD

FORMATION	CONTENT	FROM	TO	SIZE	PUT IN	PULLED OUT
	Water	125	140	12 1/2"	65'	65'
	Water	250	300	10"	415'	415'
	Gas	1585'	1590'	8"	595'	595'
	Water 1/2 B	1630'	1645'	7"	1925'	1925'
				5"	2208'	2208'

Describe in detail the manner in which the well was plugged, indicating where the mud fluid was placed and the method or methods used in introducing it into the hole. If cement or other plugs were used, state the character of same and depth placed, from 22 feet to _____ feet for each plug set.

Mudded from 2290' to 250' - set bridge at 250' - cemented with 40
sacks of cement - Mudded to 20' from top - set bridge - cemented to
bottom of cellar.

(If additional description is necessary, use BACK of this sheet)

Name of Plugging Contractor Halliburton Oil Well Cementing
Address Duncan, Oklahoma

STATE OF Kansas, COUNTY OF Russell, ss.
D. D. Haynes (employee of owner) or (owner or operator) of the above-described well, being first duly sworn on oath, says: That I have knowledge of the facts, statements, and matters herein contained and the log of the above-described well as filed and that the same are true and correct. So help me God.

(Signature) D. D. Haynes
Russell, Kansas (Address)

SUBSCRIBED AND SWORN TO before me this 12th day of October, 19 53

My commission expires March 25, 1957 Margaret Lee Williams Notary Public.

FILED
14 14 22W
134 6

10-13-1953

15-167-00047-00-00

Drilled by:
 Advance Drilling Company
 Box 44
 Russell, Kansas

Anschutz Lease

Well #1

Location: NE NE NE 14-14-12W Russell County, Kansas

Casing Record:
 12 1/2" 65'
 10" 415'
 8" 595'
 7" 1925'
 5" 2208'

FIGURES INDICATE BOTTOM OF FORMATION

Clay	50'	Blue Shale	1680'
Sand	68'	Shale	1690'
Shale	85'	Lime	1700'
Sand	95'	Red Rock	1710'
Shale Grey	125'	Lime	1725'
Blue Shale	150'	Blue Shale	1730'
Brown Shale	165'	Lime	1745'
Grey Shale	185'	Shale Blue	1750'
Red Rock	190'	Lime	1765'
Grey Shale	200'	Shale Blue	1770'
Red Rock	220'	Red Rock	1780'
Sand	250'	Lime	1800'
Grey Shale	270'	Shale	1808'
Blue Shale	305'	Lime	1825'
Grey Shale	320'	Red Rock	1830'
Blue shale	345'	Lime	1845'
Grey Shale	355'	Blue Shale	1850'
Blue Shale	375'	Lime	1865'
Red Rock	595'	Red Rock	1875'
Lime	630'	Lime	1880'
Red Rock	805'	Red Rock	1885'
Blue Shale	830'	Lime	1965'
Red Rock	900'	Shale	1970'
Blue Shale	1005'	Lime	1975'
Salt	1020'	Shale & Shells	2010'
Blue Shale	1028'	Lime	2050'
Salt	1295'	Shale	2055'
Shale & Shells	1310'	Lime	2070'
Shale	1320'	Shale	2080'
Lime	1330'	Lime	2090'
Shale & Shells	1365'	Blue Shale	2105'
Lime Shale	1380'	Shale & Shells	2157'
Shale & Shells	1400'	Lime	2175'
Lime	1415'	Red Rock	2183'
Shale	1422'	Lime	2200'
Lime	1435'	Blue Shale	2205'
Shale & Shells	1460'	Lime	2209'
Lime	1490'	Shells	2219'
Blue Shale	1497'	Sand	2221'
Lime	1510'	Sandy Shells	2227'
Blue Shale	1515'	Lime Shells	2232'
Red Rock	1545'	Dark Grey Shale & Sand	2245'
Lime	1675'	Shale	2282'
		Lime	2290'

Water Record
 125 to 140
 250 to 300
 1630 to 1645

Gas Record:
 1585' to 1590'

PLUGGING
 FILE SEC 14 T19 R12W
 BOOK PAGE 34 LINE 6

FILED
 10-13-1953
 103