

15-167-00288-00-00

STATE OF KANSAS
STATE CORPORATION COMMISSION

Give All Information Completely
Make Required Affidavit
Mail or Deliver Report to:
Conservation Division
State Corporation Commission
800 Bittling Building
Wichita, Kansas

WELL PLUGGING RECORD

Russell County, Sec. 14 Twp. 14 Rge. 12 (W)

Location as "NE/CNWxSWx" or footage from lines NE-NE-SE

Lease Owner Advance Drilling Co.

Lease Name Mahoney Well No. 1

Office Address Box 44

Character of Well (completed as Oil, Gas or Dry Hole) Dry Hole

Date well completed January 14 1955

Application for plugging filed January 14 1955

Application for plugging approved January 14 1955


Plugging commenced January 14 1955

Plugging completed January 16, 1955

Reason for abandonment of well or producing formation Dry Hole

If a producing well is abandoned, date of last production 19

Was permission obtained from the Conservation Division or its agents before plugging was commenced? Yes

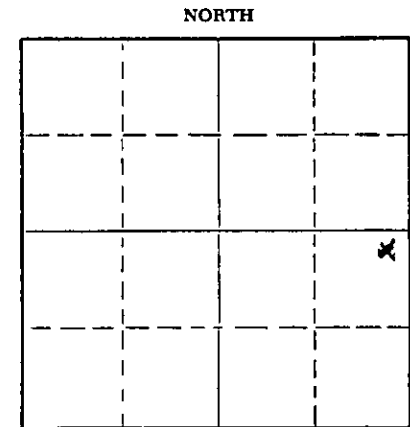

Locate well correctly on above Section Plat

Name of Conservation Agent who supervised plugging of this well Warren Horner

Producing formation None Depth to top Bottom 3225 Total Depth of Well 3225 Feet

Show depth and thickness of all water, oil and gas formations.

OIL, GAS OR WATER RECORDS

CASING RECORD

FORMATION	CONTENT	FROM	TO	SIZE	PUT IN	PULLED OUT
Sand and Shale	Water	180	185	15 1/2"	1525	1530
Red Rock	Water	500	530	12 1/2"	420	420
Lime	Show of Gas	1525	1530	10"	585	585
Lime	Show of Oil	2890	2895	8"	1885	1885
Lime	Water	2953	2960	7"	2400'	2400'
Conglomerate	Water	3200	3225	5 1/2"	2895	2897

Describe in detail the manner in which the well was plugged, indicating where the mud fluid was placed and the method or methods used in introducing it into the hole. If cement or other plugs were used, state the character of same and depth placed, from feet to feet for each plug set.

Hole mudded after each string with Halliburton mud truck. Set rock bridge at 240'. Cemented with 50 sacks of cement. Bridge set 15' on bottom of cellar. Cemented with 15 sacks cement.

(If additional description is necessary, use BACK of this sheet)

Name of Plugging Contractor Advance Drilling Co.

Address

STATE OF KANSAS, COUNTY OF RUSSELL, ss.

D. D. Haynes (employee of owner) or (owner or operator) of the above-described well, being first duly sworn on oath, says: That I have knowledge of the facts, statements, and matters herein contained and the log of the above-described well as filed and that the same are true and correct. So help me God.

(Signature) D. D. Haynes

Russell, Kansas (Address)

SUBSCRIBED AND SWORN TO before me this 20th day of January, 1955

Marjorie Lee Sumler Notary Public.

My commission expires March 25, 1957

PLUGGING
FILE SEC 14 T 14 R 12W
BOOK PAGE 92 LINE 7

01-26-1955

Drilled by: Advance Drilling Co.
 Box 44
 Russell, Kansas

Mahoney Lease

Well No. 1

Location: NE-NE-SE

Section: 14-14-12W Russell County, Kansas

Date Started: 11-24-54

Date Completed: 1-16-55

Casing Record:

15 1/2" -
 12 1/2" - 420'
 10" - 585'
 8" - 1885'
 7" - 2400'
 5 1/2" - 2895'

Water Record:

180' - HFW
 500' - 530' - 1 1/2' BFW
 2953' - 2960' - HFW
 3200' - 3225' - HFW

Elevation: 1726'

Formation Record: Figures Indicate Bottom of Formation:

Sand	60'	Brown Shale	1662'	Lime	2612'
Blue Shale	70'	Lime	1710'	Shale	2615'
Red Rock	105'	Shale	1714'	Lime	2618'
Gray Shale	150'	Lime	1735'	Shale	2625'
Sand	180'	Red Rock	1740'	Lime	2640'
Shale (Light)	185'	Lime	1785'	Shale	2643'
Red Rock	215'	Red Rock	1795'	Lime	2665'
Blue Shale	250'	Lime	1845'	Shale	2673'
Sand	255'	Red Rock	1865'	Lime	2690'
Gray Shale	265'	Lime & Red Rock	1885'	Shale	2694'
Blue Shale	287'	Lime	1906'	Lime	2769'
Hard Sand	290'	Blue Shale	1910'	Shale	2772'
Blue Shale	310'	Shale & Shells	1950'	Lime	2778'
Shale	320'	Red Rock	1955'	Shale	2786'
Blue Shale	340'	Lime (Broken)	1995'	Lime	2800'
Sand	345'	Lime	2015'	Red Rock	2804'
Blue Shale	355'	Shale	2020'	Shale & Shells	2835'
Sand	360'	Lime	2035'	Shale	2850'
Blue Shale	364'	Shale	2040'	Lime	2860'
Red Rock	578'	Lime	2045'	Shale	2866'
Chalk	580'	Shale	2055'	Lime	2880'
Lime	615'	Lime	2065'	Lime & Shale	2890'
Red Rock	780'	Shale	2070'	Lime	2910'
Blue Shale	820'	Lime	2080'	Shale	2913'
Red Rock	880'	Shale	2085'	Lime	2941'
Blue Shale	975'	Shale & Shells	2095'	Shale	2944'
Salt	1020'	Blue Shale	2100'	Lime	2950'
Red Rock	1025'	Shale & Shells	2150'	Soft Lime	2953'
Salt	1255'	Shale	2160'	Lime	2966'
Shale	1259'	Lime	2170'	Shale	2970'
Lime	1275'	Shale & Shells	2200'	Lime	2975'
Shale	1280'	Shale	2212'	Shale	2978'
Lime & Shale	1320'	Red Rock	2216'	Lime	3000'
Lime	1335'	Blue Shale	2236'	Shale	3005'
Shale & Shells	1350'	Lime	2243'	Lime	3040'
Lime	1370'	Shale	2250'	Shale	3046'
Shale & Shells	1385'	Lime	2265'	Lime	3058'
Red Rock	1390'	Shale	2295'	Shale	3063'
Lime	1405'	Lime	2335'	Lime	3075'
Blue Shale	1420'	Shale	2345'	Black Shale	3078'
Shale & Shells	1460'	Lime	2360'	Lime	3100'
Lime	1480'	Blue Shale	2365'	Shale	3102'
Blue Shale	1490'	Lime	2390'	Lime	3126'
Red Rock	1502'	Lime & Shale	2400'	Shale & Shells	3137'
Shale	1506'	Shale	2453'	Lime	3143'
Lime	1550'	Broken Lime	2460'	Shale & Shells	3164'
Shale	1555'	Lime	2485'	Lime	3166'
Lime	1640'	Shale	2493'	Shale	3169'
Shale	1648'	Lime	2520'	Conglomerate	3225'
Lime	1655'	Shale	2525'		

PLUGGING

FILE SEC 14 T 14 R 12W
 BOOK PAGE 92 LINE 2

01-26-1955