

15-167-05091-00-00

Form CP-4


STATE OF KANSAS
STATE CORPORATION COMMISSION

WELL PLUGGING RECORD

Give All Information Completely
Make Required Affidavit
Mail or Deliver Report to:
Conservation Division
State Corporation Commission
211 No. Broadway
Wichita, Kansas

Russel County. Sec. 14 Twp. 14 Rge. (E) 12(W)
Location as "NE/CNW/SW" or footage from lines SW NW SW

Lease Owner Shelley-Miller Drlg. Co.
Lease Name Walters Well No. 4
Office Address Miller Building, Wichita, Kansas
Character of Well (completed as Oil, Gas or Dry Hole) Dry Hole
Date well completed Feb. 25 19.64
Application for plugging filed Feb. 25 19.64
Application for plugging approved Feb. 25 19.64
Plugging commenced Feb. 25 19.64
Plugging completed Feb. 25 19.64
Reason for abandonment of well or producing formation Dry

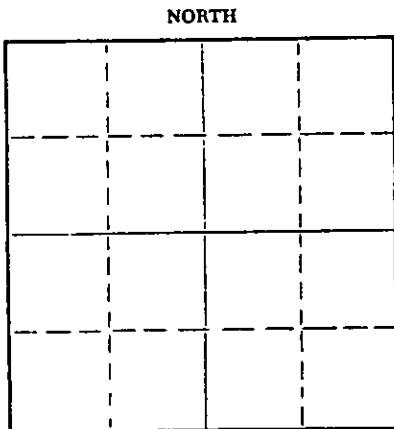

Locate well correctly on above
Section Plat

If a producing well is abandoned, date of last production 19
Was permission obtained from the Conservation Division or its agents before plugging was commenced? Yes

Name of Conservation Agent who supervised plugging of this well Donald Truan
Producing formation Depth to top Bottom Total Depth of Well 3247 Feet
Show depth and thickness of all water, oil and gas formations.

OIL, GAS OR WATER RECORDS

CASING RECORD

FORMATION	CONTENT	FROM	TO	SIZE	PUT IN	PULLED OUT
				8 5/8	209'	

Describe in detail the manner in which the well was plugged, indicating where the mud fluid was placed and the method or methods used in introducing it into the hole. If cement or other plugs were used, state the character of same and depth placed, from feet to feet for each plug set.

Bottom plug 200'w/25 sx cement
Top plug 40'w/10 sx cement

RECEIVED
STATE CORPORATION COMMISSION

MAR 5 1964
13-05-1964
CONSERVATION DIVISION
Wichita, Kansas

(If additional description is necessary, use BACK of this sheet)

Name of Plugging Contractor Woodman & Iannitti Drilling Company
Address 706 Union National Building, Wichita, Kansas

STATE OF Kansas, COUNTY OF Sedgwick, ss.
K. T. Woodman (employee of owner) or (owner or operator) of the above-described well, being first duly sworn on oath, says: That I have knowledge of the facts, statements, and matters herein contained and the log of the above-described well as filed and that the same are true and correct. So help me God.

(Signature) K. T. Woodman

706 Union National Building, Wichita, Kansas
(Address)

SUBSCRIBED AND SWORN TO before me this 4 day of March, 19 64

My commission expires Feb. 11, 1968

Justina Chamberlain
Notary Public.

15-167-05091-00-00

KANSAS GEOLOGICAL SOCIETY
KANSAS WELL LOG BUREAU - KANSAS WELL SAMPLE BUREAU
KANSAS GEOLOGICAL SOCIETY BUILDING
508 EAST MURDOCK - WICHITA, KANSAS

COMPANY Shelley-Miller Drlg. Co.

SEC. 14 T. 14 R. 12W


FARM Walter NO. 4

LOC. SW NW SW

TOTAL DEPTH 3247
COMM. 2-17-64 COMP. 2-25-64

COUNTY Russell

BHDT OR TREATED
CONTRACTOR Woodman & Iannitti Drlg. Co.
ISSUED

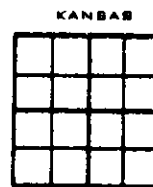

CASING

20 10
15 B 5/8 @ 209' w/135 sx.
12 6
13 5

ELEVATION 1751DF

PRODUCTION D & A

FIGURES INDICATE BOTTOM OF FORMATIONS

0	40	Post Rock & Shale
40	210	Shale & Clay
210	620	Shale
620	640	Anhy
640	650	Shale
650	1305	Shale
1305	1550	Lime & Shale
1550	1660	Shale & Lime
1660	1785	Lime
1785	2155	Shale & Lime
2155	2350	Shale
2350	2545	Shale & Lime
2545	2624	Shale & Lime
2624	2715	Lime & Shale
2715	2850	Lime
2850	2875	Shale & Lime
2875	2945	Lansing Lime
2945	2997	Lime
2997	3115	Lime & Shale
3115	3190	Lime & Shale
3190	3230	Lime
3230	3247	Lime & Shale
3247		Total Depth

RECEIVED
STATE CORPORATION COMMISSION

MAR 5 1964
03-05-1964
CONSERVATION DIVISION
Wichita, Kansas

I certify the above to be a true and correct copy of the Driller's Log and the Geological Tops to the best of my knowledge and belief.

WOODMAN & IANNITTI DRILLING COMPANY

BY: K. T. Woodman
K. T. Woodman